




99999999


08705641  
CERTIFICATE OF SURVEY

for  
H. L. Hunt

T2N R56W 6 PM.

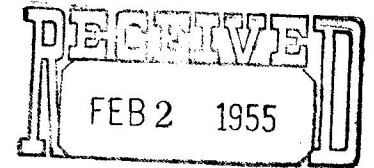

OIL & GAS  
CONSERVATION COMMISSION

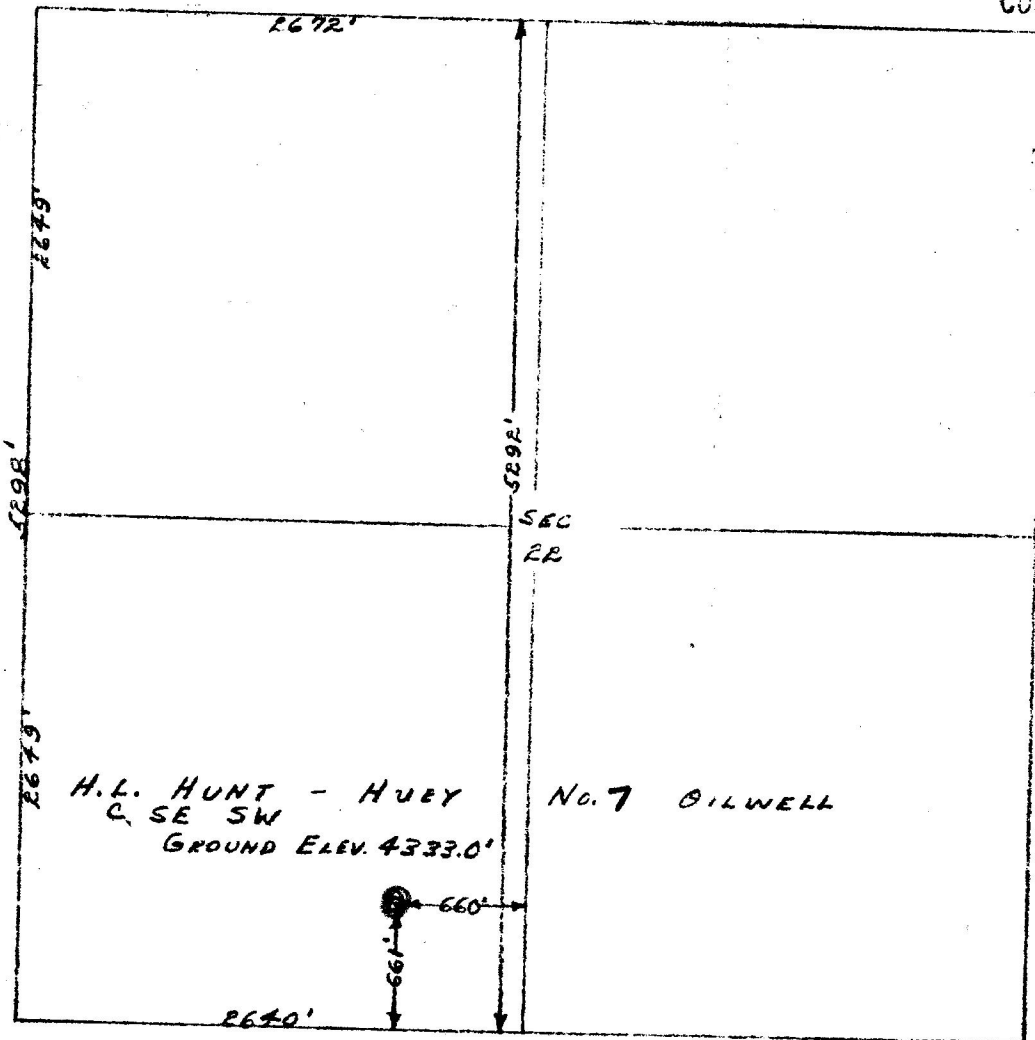

I hereby certify that the above plat is an accurate representation of a correct survey showing the location of H. L. Hunt-Huey No. 7 Oilwell located in the CSE 1/4 Sec. 22 T2N R56W 6 PM. The elevation of the ground at the stake is 4333.0 feet above sea level from B.S. & G. Bench Mark.

Fort Morgan, Colorado  
January 20, 1955

*Reed J. Robinson*  
Registered Professional Engineer  
State of Colorado



00104849