


| | | | | |
|------------|--------------|---------------|-----------|---------------|
| API: | 05-123-13849 | KB ELEVATION: | | QTR-QTR: SESE |
| WELL NAME: | State 16-2 | GROUND LEVEL: | | SECTION: 16 |
| COUNTY: | WELD | MD: | 7146 | TWNSHIP: 4N |
| LATITUDE: | | PBMD: | | RANGE: 67W |
| LONGITUDE: | | CREATED BY: | J. Jones | |
| | | DATE: | 4/19/2018 | |

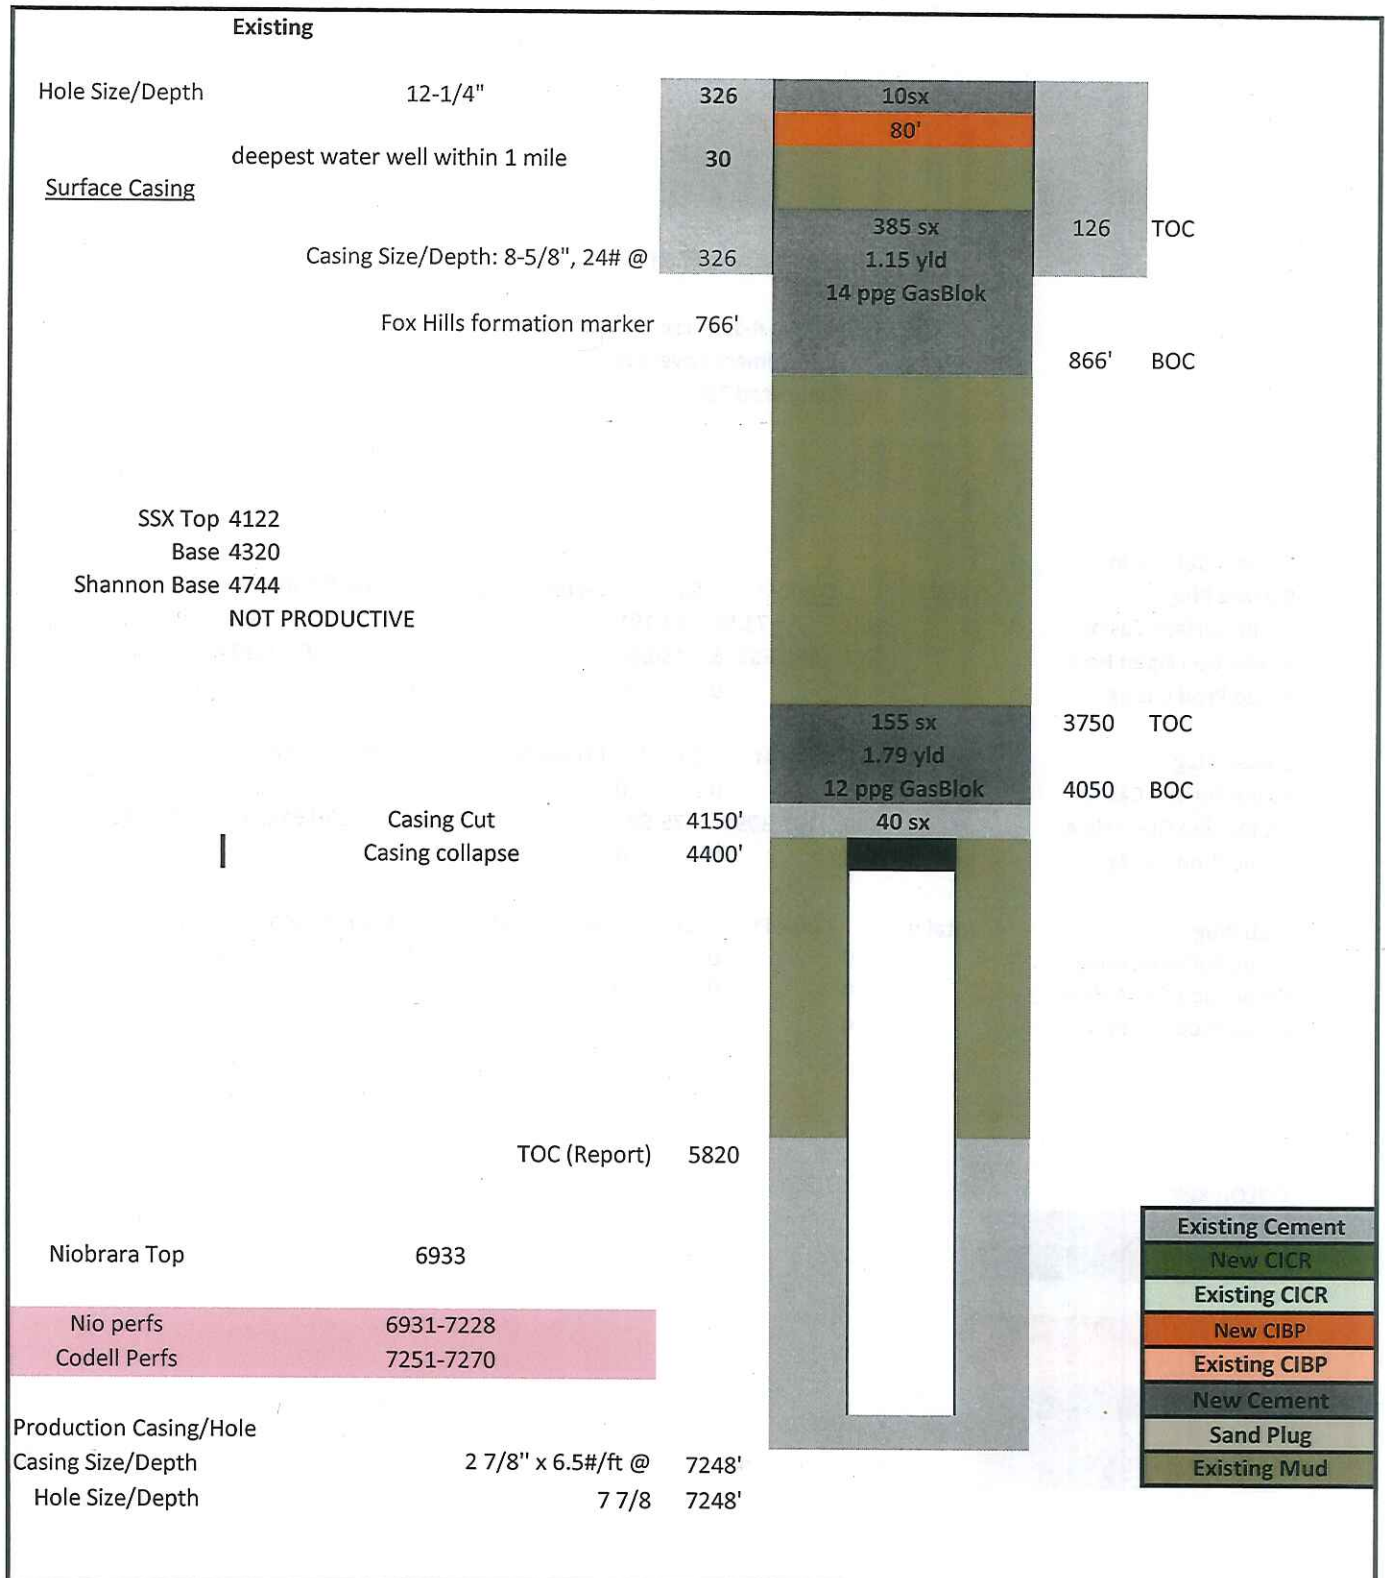

| | | | | |
|------------|--------------|---------------|-----------|---------------|
| API: | 05-123-13849 | KB ELEVATION: | | QTR-QTR: SESE |
| WELL NAME: | State 16-2 | GROUND LEVEL: | | SECTION: 16 |
| COUNTY: | Weld | MD: | 7146 | TWNSHIP: 4N |
| LATITUDE: | | PBMD: | | RANGE: 67W |
| LONGITUDE: | | CREATED BY: | J. Jones | |
| | | DATE: | 4/19/2018 | |

