



FRANE SURVEYING INC.


Physical Address: 34834 Annie Cir.
Mail to: Box 2372, Elizabeth, CO 80107
Ph. 303-243-0037
www.francesurveying.com
Job # 18-087-Zion 1-1

Frane Surveying of Elizabeth, Colorado, has in accordance with a request from **Grand Mesa Operating CO.** has determined the location of **Zion 1-1** to be **601 feet FNL**, and **247 feet FWL**, of SECTION **1**, Township **8s**, Range **55w** of the 6th Principal Meridian, **Lincoln County**, Colorado.

Date: Staked on 04/18/18 drawn on 04/20/18.

Re:
Drawn:

Staked by Elijah Frane
Drawn by Elijah Frane

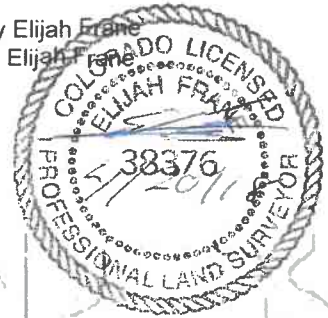

Access Road Map

