


WELL LOCATION PLAT RAINANCE 29E-20-4C

SE 1/4 SE 1/4 SEC. 30, T6N, R67W, 6TH P.M.

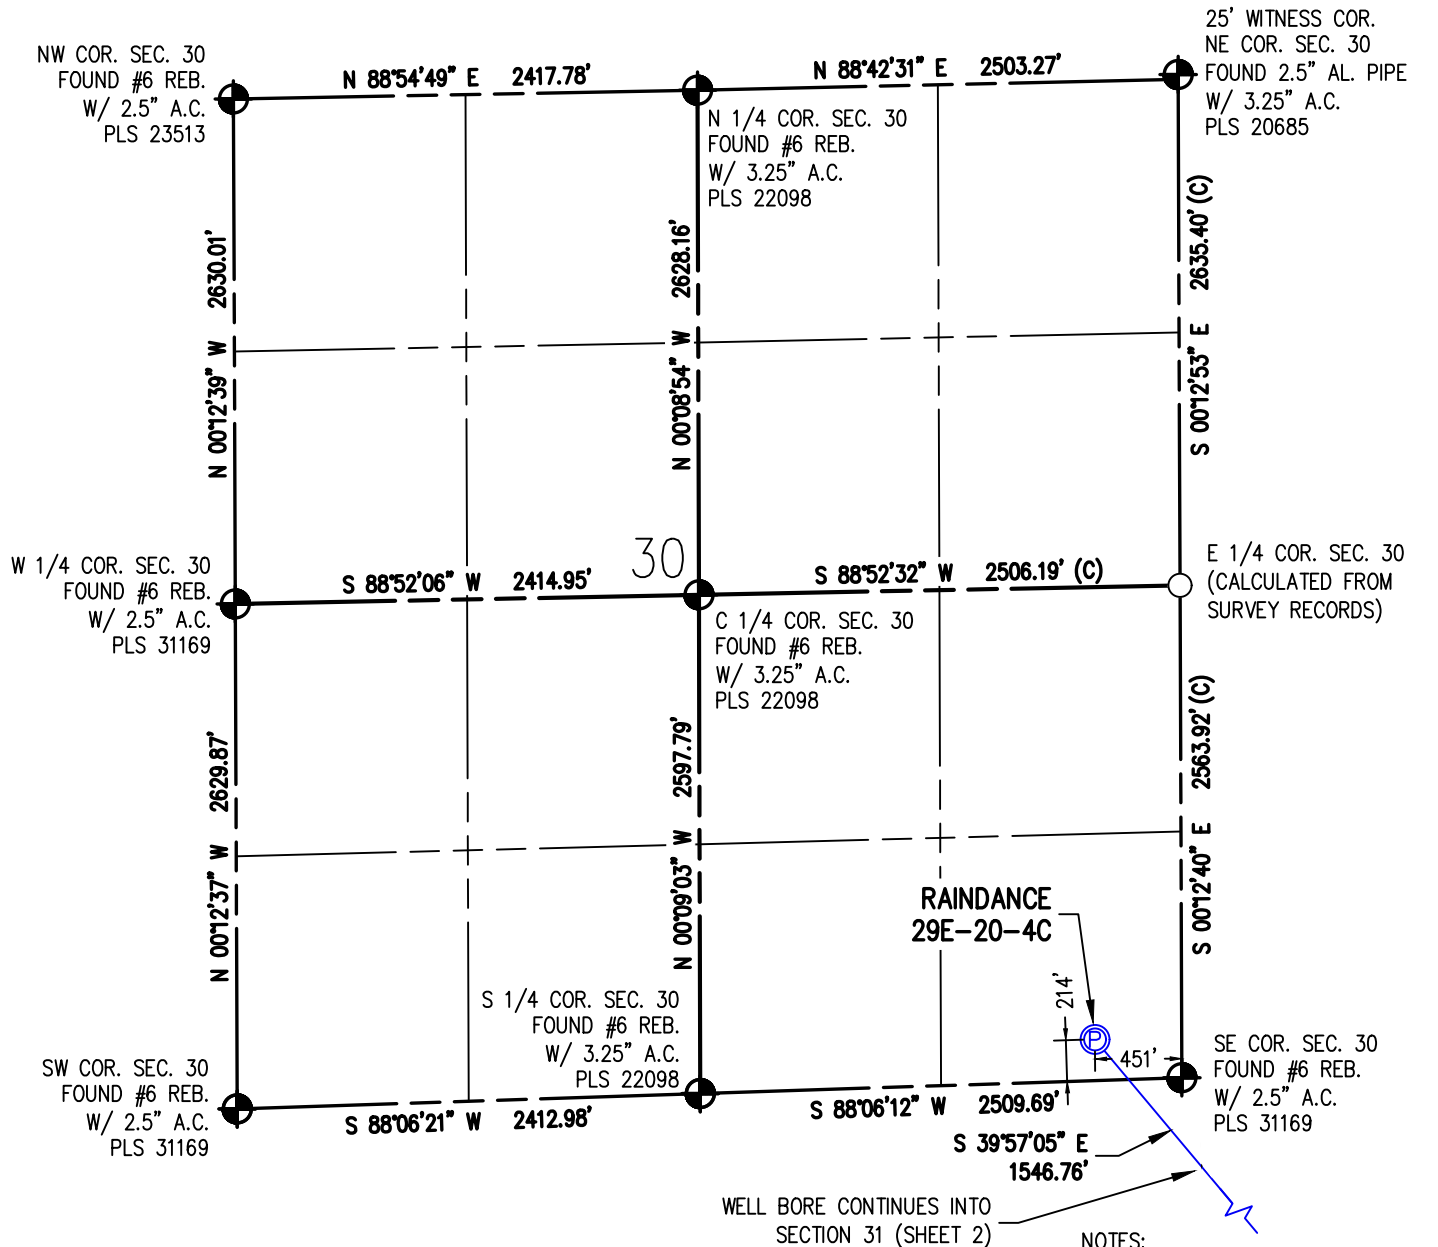

I HEREBY CERTIFY THAT THIS WELL LOCATION CERTIFICATE WAS PREPARED BY ME, OR UNDER MY DIRECT SUPERVISION, THAT THE FIELD WORK WAS COMPLETED ON 3/2/2017, THAT IT IS NOT A LAND SURVEY PLAT OR AN IMPROVEMENT SURVEY PLAT, AND THAT IT IS NOT TO BE RELIED UPON FOR ESTABLISHMENT OF FENCE, BUILDING OR OTHER FUTURE IMPROVEMENT LINES.

AARON A. DEMO
Professional Land Surveyor Registration No. 38285
State of Colorado
FOR AND ON BEHALF OF BASELINE ENGINEERING CORP.

N

Scale 1" = 1000' ft

SURFACE LOCATION
SEC. 30, T6N, R67W
GROUND ELEVATION = 4977.7'
PDOP = 1.3
LATITUDE = 40.451285°
LONGITUDE = -104.928123°
214' FSL, 451' FEL
ENTRY POINT LOCATION
SEC. 32, T6N, R67W
LATITUDE = 40.448014°
LONGITUDE = -104.924583°
990' FNL, 460' FWL
BOTTOM HOLE LOCATION
SEC. 33, T6N, R67W
LATITUDE = 40.447979°
LONGITUDE = -104.890831°
994' FNL, 460' FEL

NOTES:


1. INDICATES SECTION CORNER
2. INDICATES CALCULATED CORNER
3. (C) INDICATES CALCULATED DIMENSION
4. ELEVATION BASED ON NAVD88 (GEOID12B)
5. BEARINGS DERIVED FROM COLORADO COORDINATE SYSTEM OF 1983 NORTH ZONE.
6. OPERATOR: JEFF VAN HORN
7. IMPROVEMENTS: SEE LOCATION DRAWING FOR ALL VISIBLE IMPROVEMENTS WITHIN 500' OF DISTURBED AREA.
8. WELL FOOTAGES ARE MEASURED AT RIGHT ANGLES TO THE SECTION LINES.

NEAREST CULTURAL ITEMS:

BUILDING: 696' NE
BUILDING UNIT: 814' SE
HIGH OCCUPANCY BUILDING UNIT: 5280'+
DESIGNATED OUTSIDE ACTIVITY AREA: 5280'+
PUBLIC ROAD: WELD COUNTY ROAD 64 222' S
ABOVE GROUND UTILITY: 5280'+
RAILROAD: 5280'+
PROPERTY LINE: 142' NE
SURFACE USE: GRASSLAND.
NEAREST EXISTING WELL: RAINANCE 8 15' E




DRAWN BY	CHECKED BY
RPM	AAD
INITIAL SUBMITTAL	2/14/2018
REVISED	2/21/2018
DRAWING SIZE	8.5" X 11"
JOB NO.	EXT06N67W30-01
SHEET	1 OF 4

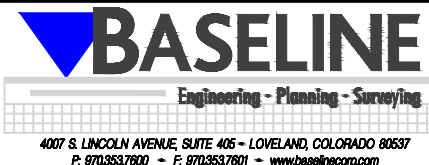

4007 S. LINCOLN AVENUE, SUITE 405 - LOVELAND, COLORADO 80537
P: 970.353.7600 - F: 970.353.7601 - www.baselinecorp.com

WELL LOCATION PLAT RAINANCE 29E-20-4C

SE 1/4 SE 1/4 SEC. 30, T6N, R67W, 6TH P.M.

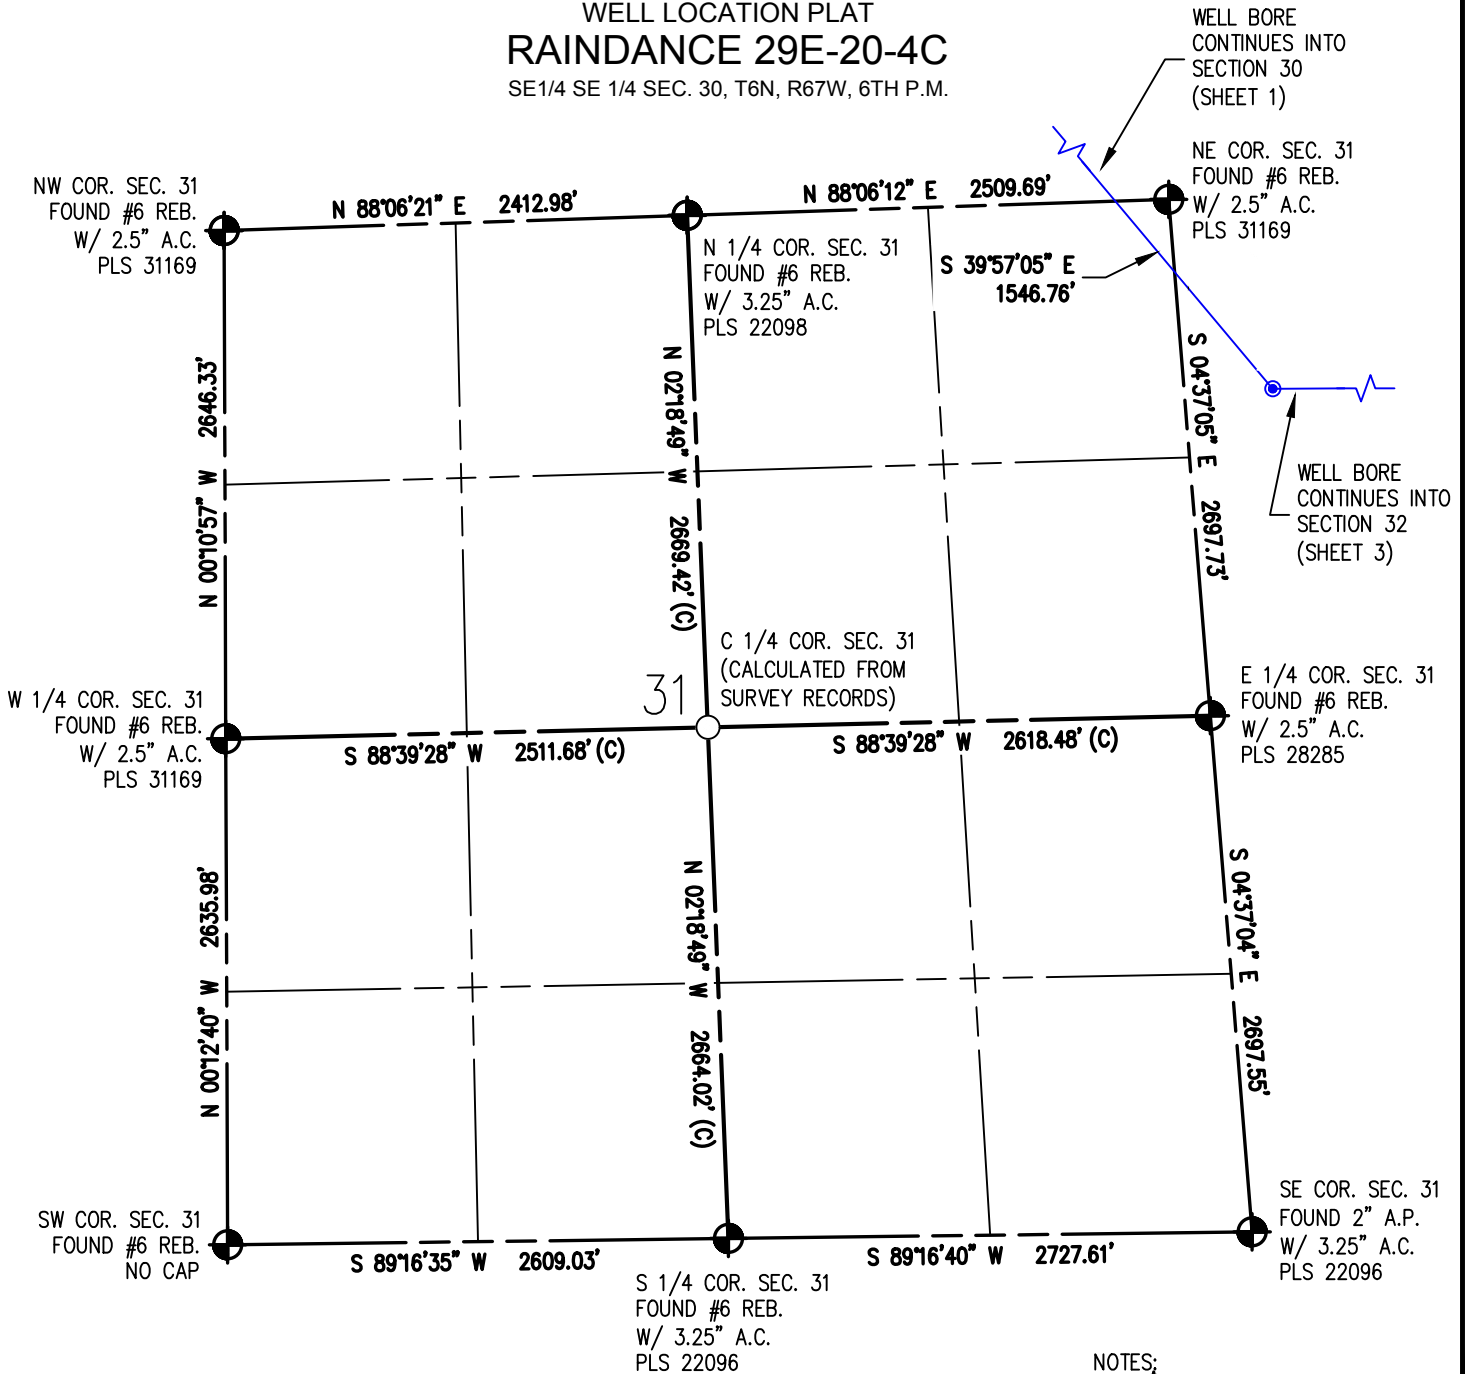

I HEREBY CERTIFY THAT THIS WELL LOCATION CERTIFICATE WAS PREPARED BY ME, OR UNDER MY DIRECT SUPERVISION, THAT THE FIELD WORK WAS COMPLETED ON 3/2/2017, THAT IT IS NOT A LAND SURVEY PLAT OR AN IMPROVEMENT SURVEY PLAT, AND THAT IT IS NOT TO BE RELED UPON FOR ESTABLISHMENT OF FENCE, BUILDING OR OTHER FUTURE IMPROVEMENT LINES.

AARON A. DEMO
Professional Land Surveyor Registration No. 38285
State of Colorado
FOR AND ON BEHALF OF BASELINE ENGINEERING CORP.



Scale 1" = 1000' ft

SURFACE LOCATION
SEC. 30, T6N, R67W
GROUND ELEVATION = 4977.7'
PDOP = 1.3
LATITUDE = 40.451285°
LONGITUDE = -104.928123°
214' FSL, 451' FEL
ENTRY POINT LOCATION
SEC. 32, T6N, R67W
LATITUDE = 40.448014°
LONGITUDE = -104.924583°
990' FNL, 460' FWL
BOTTOM HOLE LOCATION
SEC. 33, T6N, R67W
LATITUDE = 40.447979°
LONGITUDE = -104.890831°
994' FNL, 460' FEL

NOTES:

1. INDICATES SECTION CORNER
2. INDICATES CALCULATED CORNER
3. (C) INDICATES CALCULATED DIMENSION
4. ELEVATION BASED ON NAVD88 (GEOID12B)
5. BEARINGS DERIVED FROM COLORADO COORDINATE SYSTEM OF 1983 NORTH ZONE.
6. OPERATOR: JEFF VAN HORN
7. IMPROVEMENTS: SEE LOCATION DRAWING FOR ALL VISIBLE IMPROVEMENTS WITHIN 500' OF DISTURBED AREA.
8. WELL FOOTAGES ARE MEASURED AT RIGHT ANGLES TO THE SECTION LINES.

NEAREST CULTURAL ITEMS:

BUILDING: 696' NE
BUILDING UNIT: 814' SE
HIGH OCCUPANCY BUILDING UNIT: 5280'+
DESIGNATED OUTSIDE ACTIVITY AREA: 5280'+
PUBLIC ROAD: WELD COUNTY ROAD 64 222' S
ABOVE GROUND UTILITY: 5280'+
RAILROAD: 5280'+
PROPERTY LINE: 142' NE
SURFACE USE: GRASSLAND
NEAREST EXISTING WELL: RAINANCE 8 15' E




DRAWN BY	RPM	CHECKED BY	AAD
INITIAL SUBMITTAL	2/14/2018		
REVISED	2/21/2018		
DRAWING SIZE	8.5" X 11"		
JOB NO.	EXT06N67W30-01		
SHEET	2 OF 4		

BASELINE
Engineering - Planning - Surveying
4007 S. LINCOLN AVENUE, SUITE 405 • LOVELAND, COLORADO 80537
P: 970.353.7600 • F: 970.353.7601 • www.baselinecorp.com

WELL LOCATION PLAT RAINANCE 29E-20-4C

SE 1/4 SE 1/4 SEC. 30, T6N, R67W, 6TH P.M.

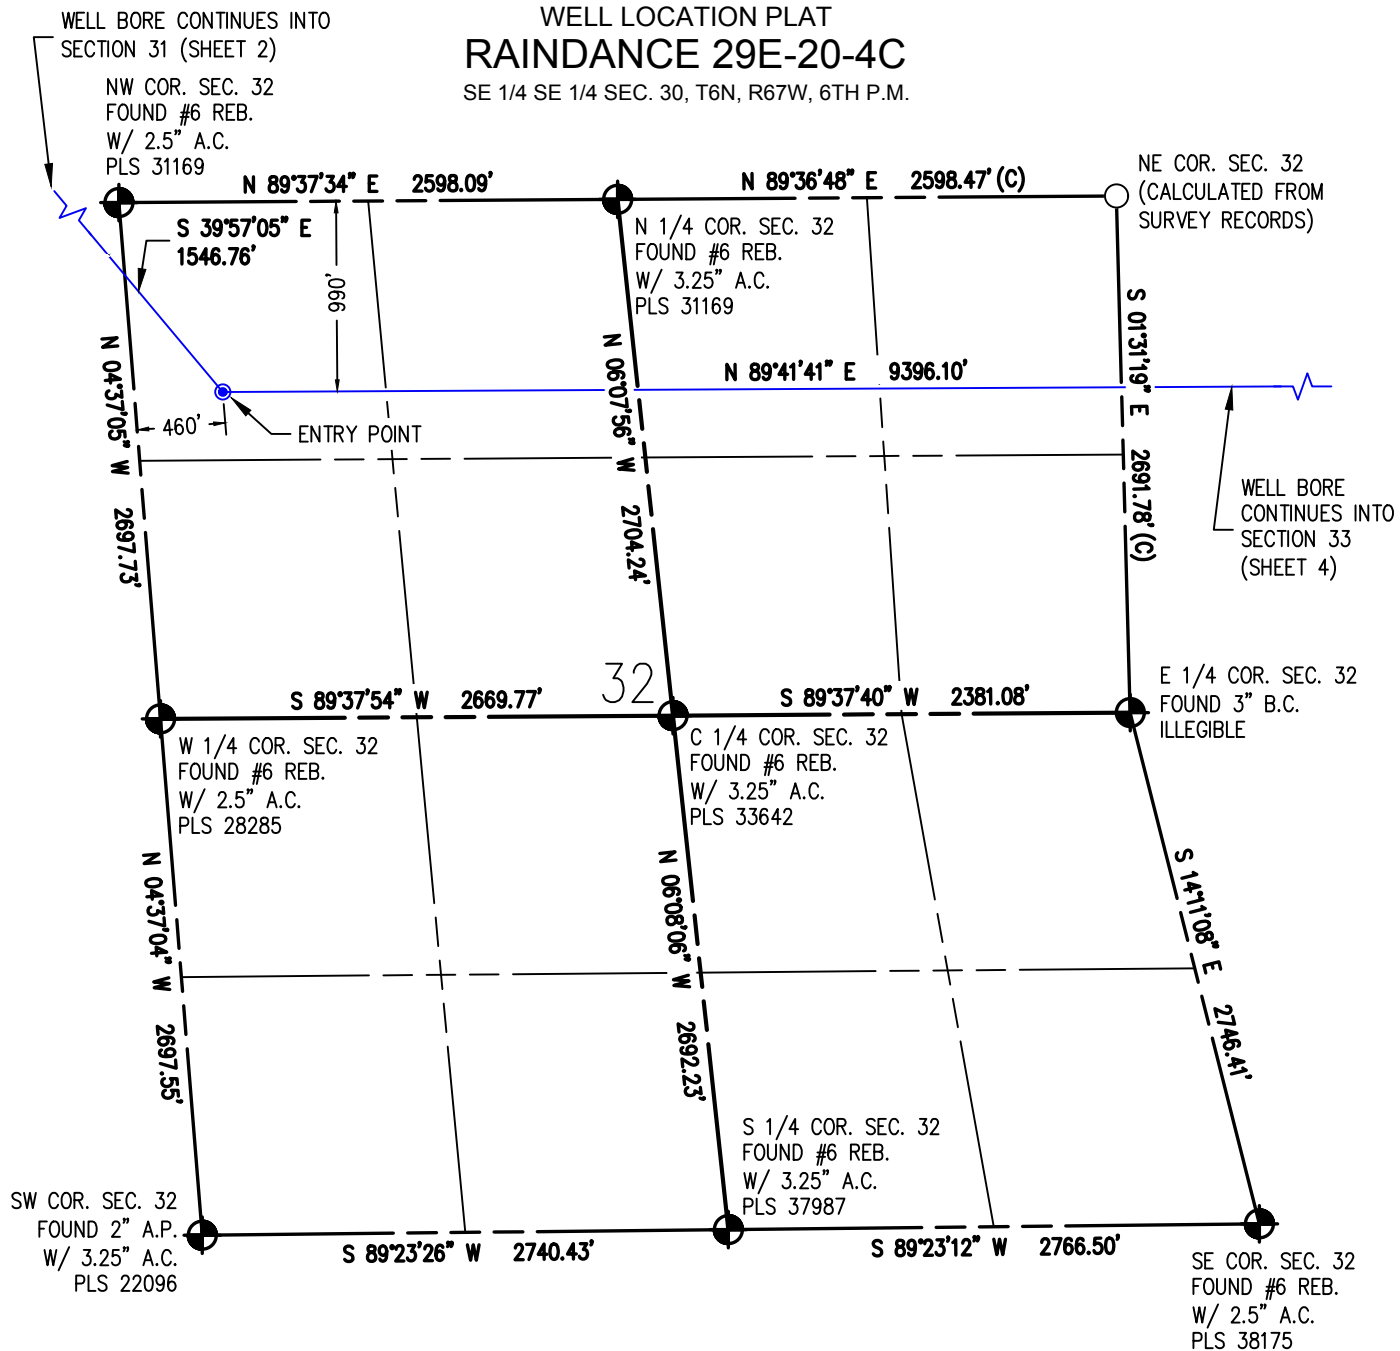


NOTES:

1. INDICATES SECTION CORNER
2. INDICATES CALCULATED CORNER
3. (C) INDICATES CALCULATED DIMENSION
4. ELEVATION BASED ON NAVD88 (GEOID12B)
5. BEARINGS DERIVED FROM COLORADO COORDINATE SYSTEM OF 1983 NORTH ZONE.
6. OPERATOR: JEFF VAN HORN
7. IMPROVEMENTS: SEE LOCATION DRAWING FOR ALL VISIBLE IMPROVEMENTS WITHIN 500' OF DISTURBED AREA.
8. WELL FOOTAGES ARE MEASURED AT RIGHT ANGLES TO THE SECTION LINES.

SURFACE LOCATION
SEC. 30, T6N, R67W
GROUND ELEVATION = 4977.7'
PDOP = 1.3
LATITUDE = 40.451285°
LONGITUDE = -104.928123°
214' FSL, 451' FEL
ENTRY POINT LOCATION
SEC. 32, T6N, R67W
LATITUDE = 40.448014°
LONGITUDE = -104.924583°
990' FNL, 460' FWL
BOTTOM HOLE LOCATION
SEC. 33, T6N, R67W
LATITUDE = 40.447979°
LONGITUDE = -104.890831°
994' FNL, 460' FEL

I HEREBY CERTIFY THAT THIS WELL LOCATION CERTIFICATE WAS PREPARED BY ME, OR UNDER MY DIRECT SUPERVISION, THAT THE FIELD WORK WAS COMPLETED ON 3/2/2017, THAT IT IS NOT A LAND SURVEY PLAT OR AN IMPROVEMENT SURVEY PLAT, AND THAT IT IS NOT TO BE RELED UPON FOR ESTABLISHMENT OF FENCE, BUILDING OR OTHER FUTURE IMPROVEMENT LINES.

AARON A. DEMO
Professional Land Surveyor Registration No. 38285
State of Colorado
FOR AND ON BEHALF OF BASELINE ENGINEERING CORP.

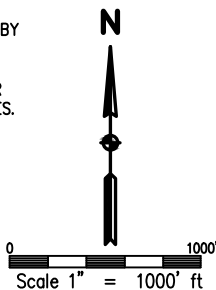


NEAREST CULTURAL ITEMS:

BUILDING: 696' NE
BUILDING UNIT: 814' SE
HIGH OCCUPANCY BUILDING UNIT: 5280'+
DESIGNATED OUTSIDE ACTIVITY AREA: 5280'+
PUBLIC ROAD: WELD COUNTY ROAD 64 222' S
ABOVE GROUND UTILITY: 5280'+
RAILROAD: 5280'+
PROPERTY LINE: 142' NE
SURFACE USE: GRASSLAND,
NEAREST EXISTING WELL: RAINANCE 8 15' E



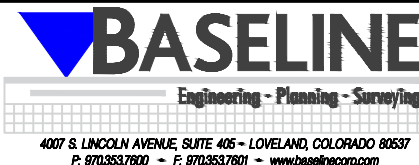

DRAWN BY	RPM	CHECKED BY	AAD
INITIAL SUBMITTAL	2/14/2018		
REVISED	2/21/2018		
DRAWING SIZE	8.5" X 11"		
JOB NO.	EXT06N67W30-01		
SHEET	3 OF 4		



SE 1/4 SE 1/4 SEC. 30, T6N, R67W, 6TH P.M.

SE 1/4 SE 1/4 SEC. 30, T6N, R67W, 6TH P.M.



1.  INDICATES SECTION CORNER
2.  INDICATES CALCULATED CORNER
3. (C) INDICATES CALCULATED DIMENSION
4. ELEVATION BASED ON NAVD88 (GEOID12B)
5. BEARINGS DERIVED FROM COLORADO COORDINATE SYSTEM OF 1983 NORTH ZONE.
6. OPERATOR: JEFF VAN HORN
7. IMPROVEMENTS: SEE LOCATION DRAWING FOR ALL VISIBLE IMPROVEMENTS WITHIN 500' OF DISTURBED AREA.
8. WELL FOOTAGES ARE MEASURED AT RIGHT ANGLES TO THE SECTION LINES.

SURFACE LOCATION
GROUND ELEVATION = 4977.7'
PDOP = 1.3
LATITUDE = 40.451285°
LONGITUDE = -104.928123°
214' FSL, 451' FEL
ENTRY POINT LOCATION
SEC. 32, T6N, R67W
LATITUDE = 40.448014°
LONGITUDE = -104.924583°
990' FNL, 460' FWL
BOTTOM HOLE LOCATION
SEC. 33, T6N, R67W
LATITUDE = 40.447979°
LONGITUDE = -104.890831°
994' FNL, 460' FEL

I HEREBY CERTIFY THAT THIS WELL LOCATION CERTIFICATE WAS PREPARED BY ME, OR UNDER MY DIRECT SUPERVISION, THAT THE FIELD WORK WAS COMPLETED ON 3/2/2017, THAT IT IS NOT A LAND SURVEY PLAT OR AN IMPROVEMENT SURVEY PLAT, AND THAT IT IS NOT TO BE RELIED UPON FOR ESTABLISHMENT OF FENCE, BUILDING OR OTHER FUTURE IMPROVEMENT LINES.

AARON A. DEMO
Professional Land Surveyor Registration No. 38285
State of Colorado

NEAREST CULTURAL ITEMS:

BUILDING: 696' NE
BUILDING UNIT: 814' SE
HIGH OCCUPANCY BUILDING UNIT: 5280'+
DESIGNATED OUTSIDE ACTIVITY AREA: 5280'+
PUBLIC ROAD: WELD COUNTY ROAD 64 222' S
ABOVE GROUND UTILITY: 5280'+
RAILROAD: 5280'+
PROPERTY LINE: 142' NE
SURFACE USE: GRASSLAND.



DRAWN BY RPM	CHECKED BY AAD
INITIAL SUBMITTAL	2/14/2018
REVISED	2/21/2018
SHEET 4 OF 4	

BASELINE
Engineering - Planning - Surveying
4007 S. LINCOLN AVENUE, SUITE 405 • LOVELAND, COLORADO 80537
