
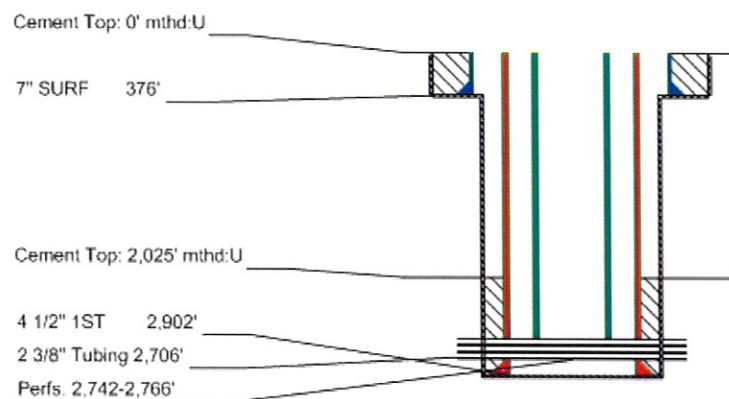


Well Completion Diagram

API Well No: 05-125-08689-00-						
Owner:	ROSEWOOD RESOURCES INC			Well Name:	EYESTONE	
County:	YUMA	Field:	BUFFALO GRASS	Pool:		
Coordinates: X	644 FEL	; Y	1987 FNL	Sec:	34	Twp: 4N Rng: 47W

Note: Changes to the drawing do not effect the database

Bore Diameters (in.)

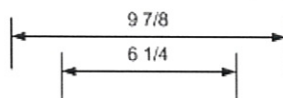

