

Legend

- ◊ - Field Surveyed Section Corner
- ◆ - Field Surveyed Quarter Corner
- ⊙ - Calculated Section Corner Location
- ⊕ - Field Surveyed 1/16 Corner

Conductor in Place
Surface: Norcross A6
 1388' FSL
 1430' FWL
 Gnd El= 5493
 Pad El= 5493
NAD83
 Lat: 39.523001367°N
 Long: 107.728694466°W


Bottom: Norcross A6
 1256' FSL
 1591' FWL
NAD83
 Lat: 39.5226391°N
 Long: 107.7281221°W

Notes:

1. LATITUDE AND LONGITUDE COORDINATES ARE DIFFERENTIALLY CORRECTED AND BASED ON PUBLISHED NGS CONTROL STATION "WDP-5". SYSTEM: UTM ZONE: 13 NORTH DATUM: NAD 1983 (CONUS)
2. ELEVATIONS ARE BASED ON NAVD OF 1988.
3. ALL BOTTOM AND TOP HOLE LOCATIONS ARE MEASURED 90 DEGREES FROM SECTION LINE.
4. USGS QUADRANGLE MAP "SILT".
5. CURRENT SURFACE LAND USE: GAS PAD.
6. PDOP AT THE TIME OF LOCATION OF SURFACE WELL =1.2
7. GPS OPERATOR: P. HOFFMANN

SURVEYOR'S CERTIFICATE

I, SCOTT E. AIBNER, A REGISTERED LAND SURVEYOR, LICENSED UNDER THE LAWS OF THE STATE OF COLORADO, HEREBY CERTIFY THAT THE SURVEY SHOWN HEREON WAS PREPARED BY RIVER VALLEY SURVEY, INC., FOR URSA OPERATING COMPANY LLC BY ME OR UNDER MY DIRECT SUPERVISION AND HAS BEEN STAKED ON THE GROUND AS SHOWN ON THE PLAT AND THAT THIS PLAT IS A TRUE REPRESENTATION THEREOF.

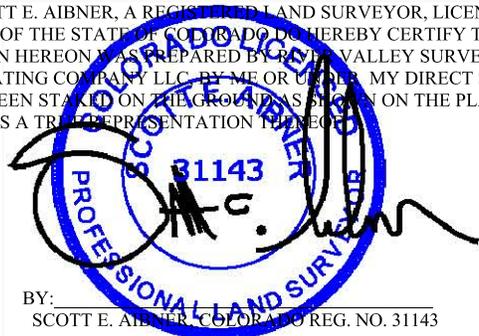

BY: SCOTT E. AIBNER, COLORADO REG. NO. 31143

Prepared For: Ursa Operating Company LLC
Proposed Norcross A6 Well, Surface Situate in The
NE1/4 SW1/4 Section 13, Township 6 South, Range 93 West
of the 6 th. Principal Meridian, County of Garfield, State
of Colorado.



RVS River Valley Survey, Inc.
 110 East 3rd. Street, Suite 213
 Rifle, Colorado 81650
 Ph: 970-379-7846

Project: RVS 06001-01	
Field Date: 3-02-18	Scale: 1"= 1000'
Date: 3-09-18	Sheet: 1 of 1

303.a Form 2
Well Location Plat
Norcross A6 Well
 Section 13, Township 6 South, Range 93 West