


Wellbore Schematic Input Report

Well Name: STATE 01

VERTICAL - ORIGINAL HOLE, 5/31/2018 10:28:31 AM

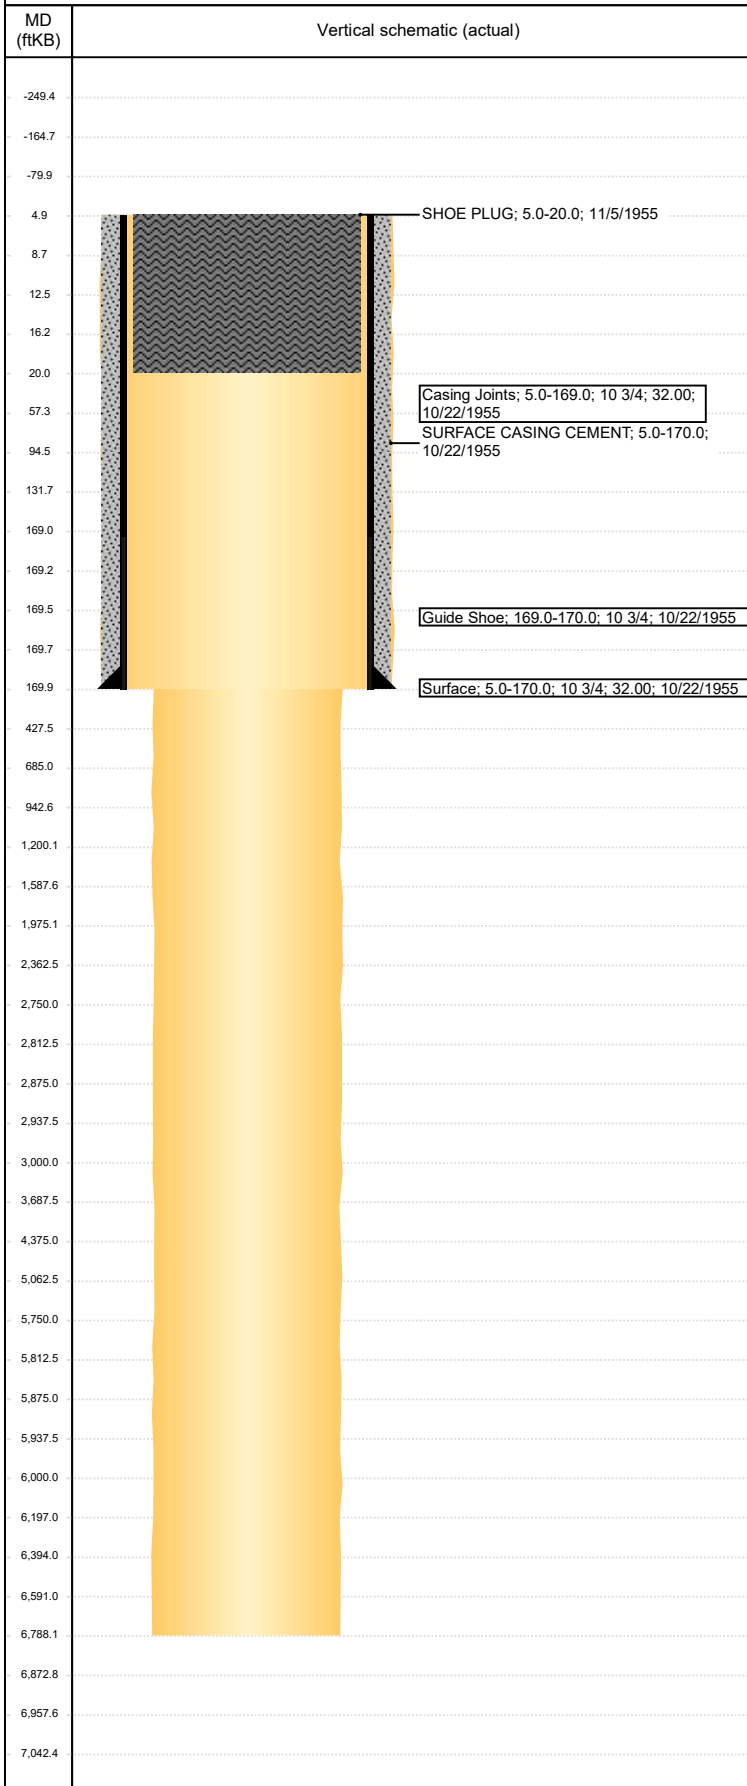

Well Header

API 05-123-05556	Well Report Center	Well Configuration Type VERTICAL
Original KB Elevation (ft)	KB - GL / MSL (ftKB)	Spud Date 10/22/1955
Production Route	Well Production Status PA	P & A Date 11/5/1955
Directions To Well	Actual Latitude (°) 40.65656500	Actual Longitude (°) -103.98891900

Comment
NO RECORDS OR INFO ON P&A OF WELL. ASSUMED 10 SX SURFACE PLUG ON TOP.

GL ELEV AVAILABLE BUT NOT KB ELEV. ASSUMED KB OF 5 FT BASED ON OTHER DA WELLS.

Congressional Location

Quarter 3 SW	Quarter 4 SW	Section 16	Township 8	Twntshp N/S Dir N	Range 59	Range E/W Dir W
-----------------	-----------------	---------------	---------------	----------------------	-------------	--------------------

Rig Operator

Rig Operator

Plug Back Total Depths

Date	Depth (ftKB)	Method	Com

Wellbore Sections

Section Des	Size (in)	Act Top, MD (ftKB)	Act Btm, MD (ftKB)
SURFACE	12 1/4	5	170
PRODUCTION	7 7/8	170	6,788

Zone Statuses

Zone Name	Status Date	Status

Casing Strings

Surface, 170.0ftKB

Casing Description	Run Date	OD (in)	Wt/Len (l...)	Grade	Top, MD (ft...)	MD (ftKB)
Surface	10/22/1955	10 3/4	32.00		5.0	170.0

Cement

Des	Start Date	Top (ftKB)	Btm (ftKB)
SURFACE CASING CEMENT	10/22/1955	5.0	170.0
SHOE PLUG	11/5/1955	5.0	20.0

Proposed Cement

Des	Top (ftKB)	Btm (ftKB)
BALANCED PLUG	2,750.0	3,000.0
BALANCED PLUG	5,750.0	6,000.0
SHOE PLUG	5.0	170.0
SHOE PLUG	170.0	1,200.0

Tubing Strings

Tubing Description	Run Date	String...	ID (in)	Wt (lb/ft)	Grade	Len (ft)	Set De...

Other In Hole

Run Date	Des	OD (in)	Top (ftKB)	Btm (ftKB)

Proposed Other In Hole

Des	OD (in)	Top (ftKB)	Btm (ftKB)

Logs

Date	Type	Top, MD (ftKB)	Btm, MD (ftKB)

Job Supply Amounts

Supply Item Des	Type	Uni...	Job Category	Total...	Total...	Total...