


**CAL-UP 26-E**  
**API 05-103-40121**

**CURRENT**

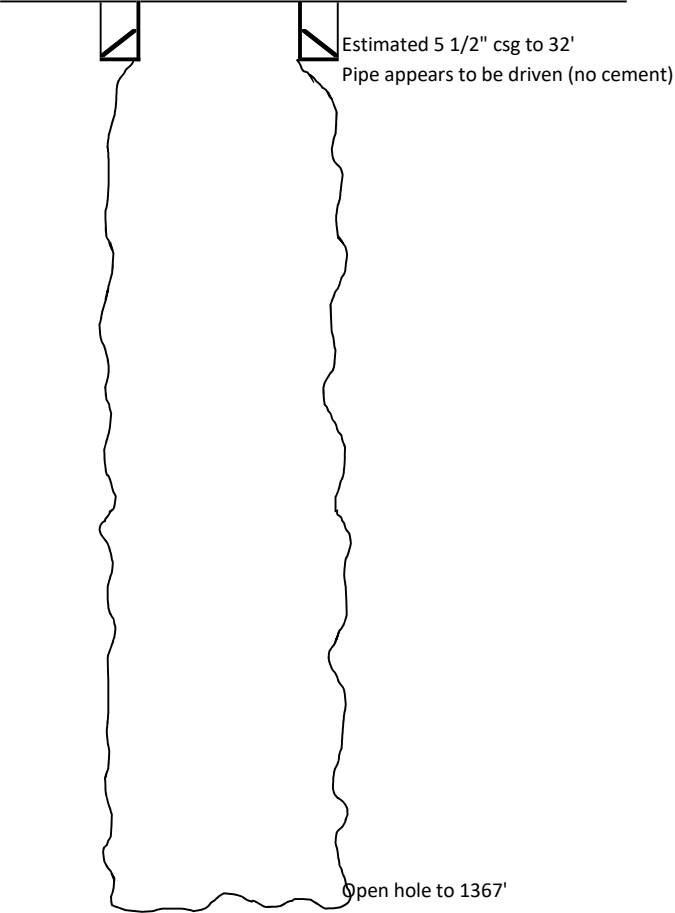

**PROPOSED P&A**

