


Terra Energy Partners
RU 314-17
Rulison Field
Section 17 T 7S-R93W

Formation Tops
(Measured Depths)

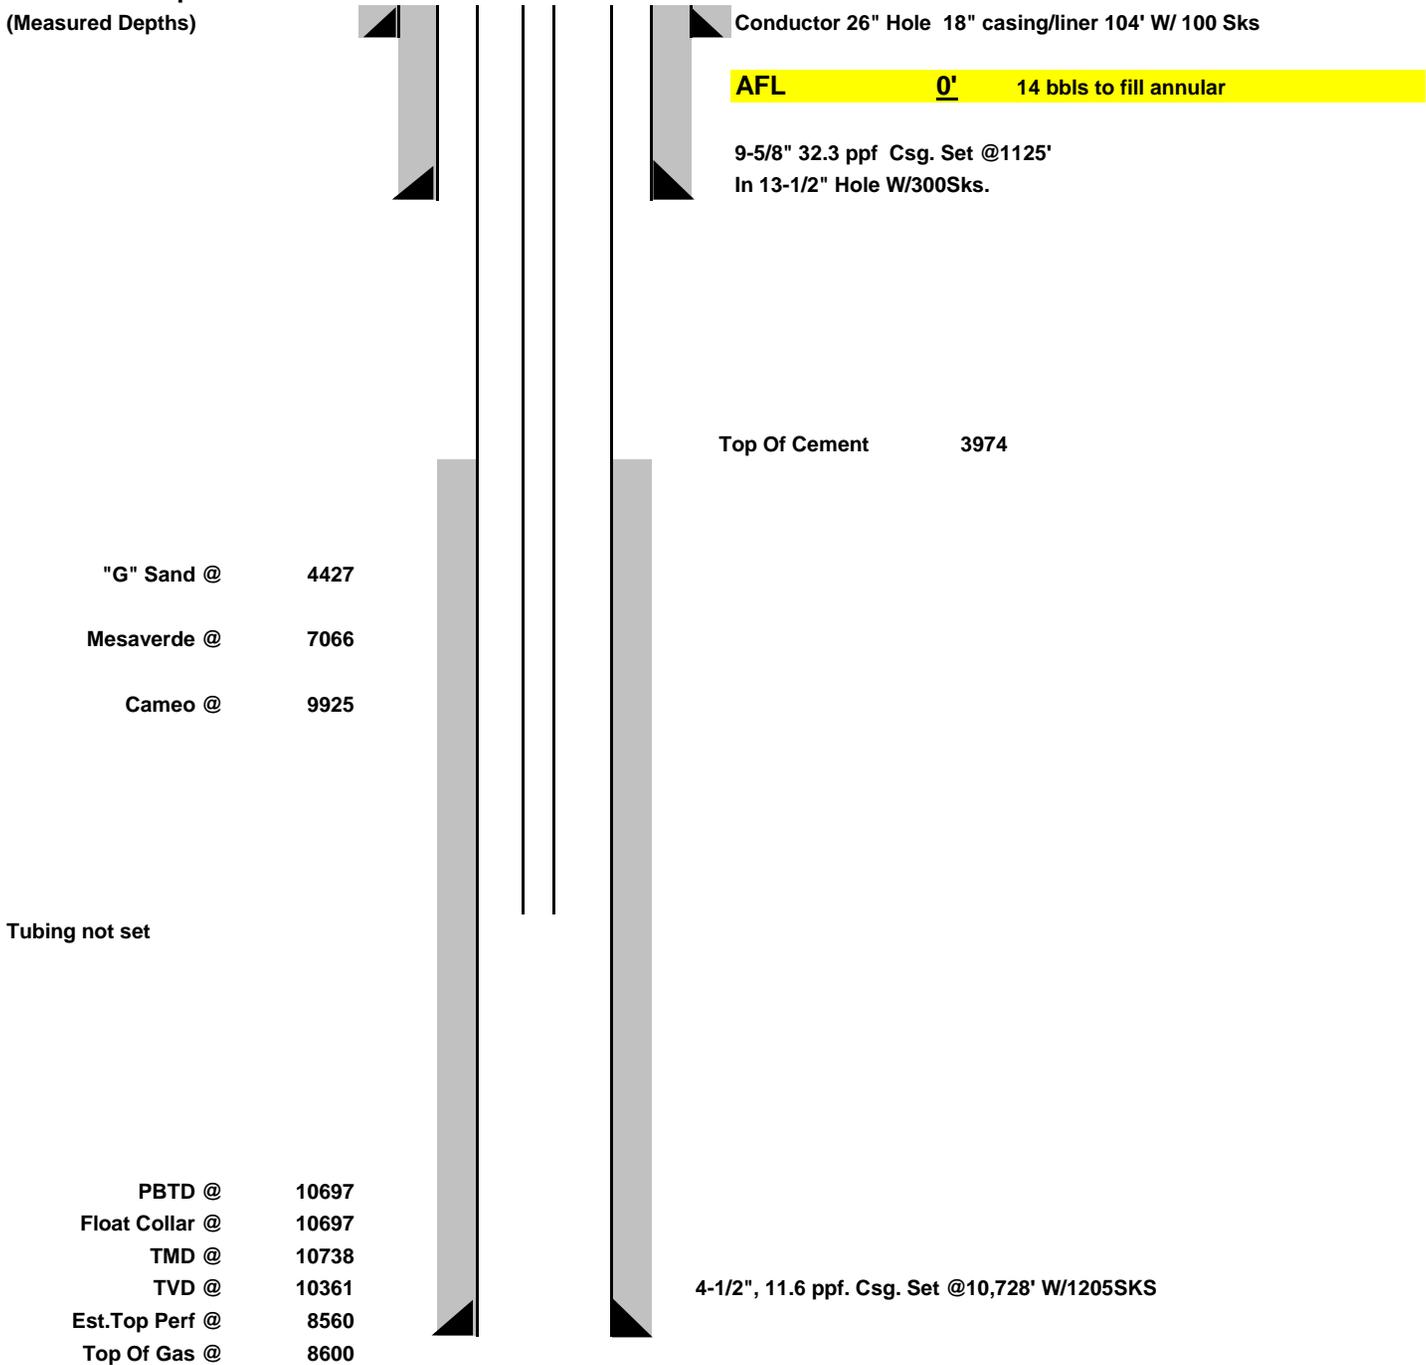

Tubing not set