


K3 OIL & GAS OPERATING

Well Bore Schematic

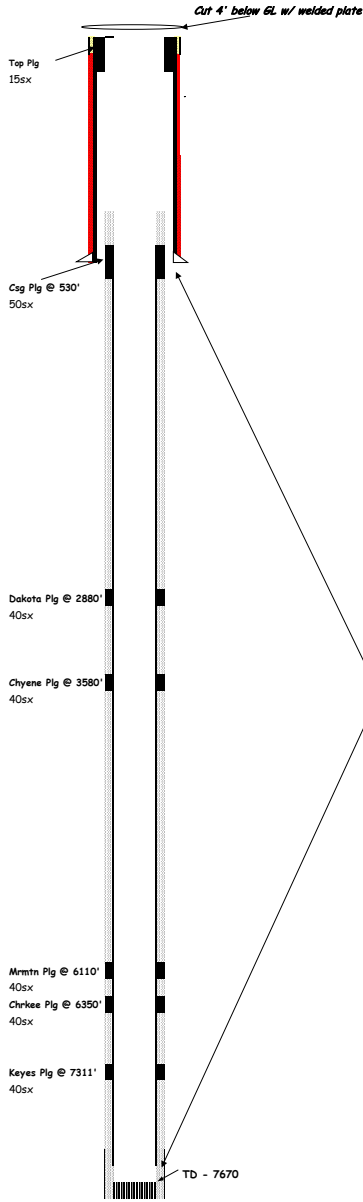

Well Name: James 6-3
Diagram Date: 6/20/2018

Surface Location: 2100' FNL 2300' FWL
Sec-T-R: Section 3 - T15S-R55W
Field: Wildcat
County: Lincoln County
State: Colorado

API No.: 05-073-06739-00

G.L. Elevation: 5144'
K.B. Elevation: 5162'

TD: 5/6/2018
5/23/2018

Surface Casing: 8-5/8", 24#, set @ 484' w/400 sxs

Open Hole: 7-7/8" 484' to 7670'