


# T5S, R96W, 6th P.M.

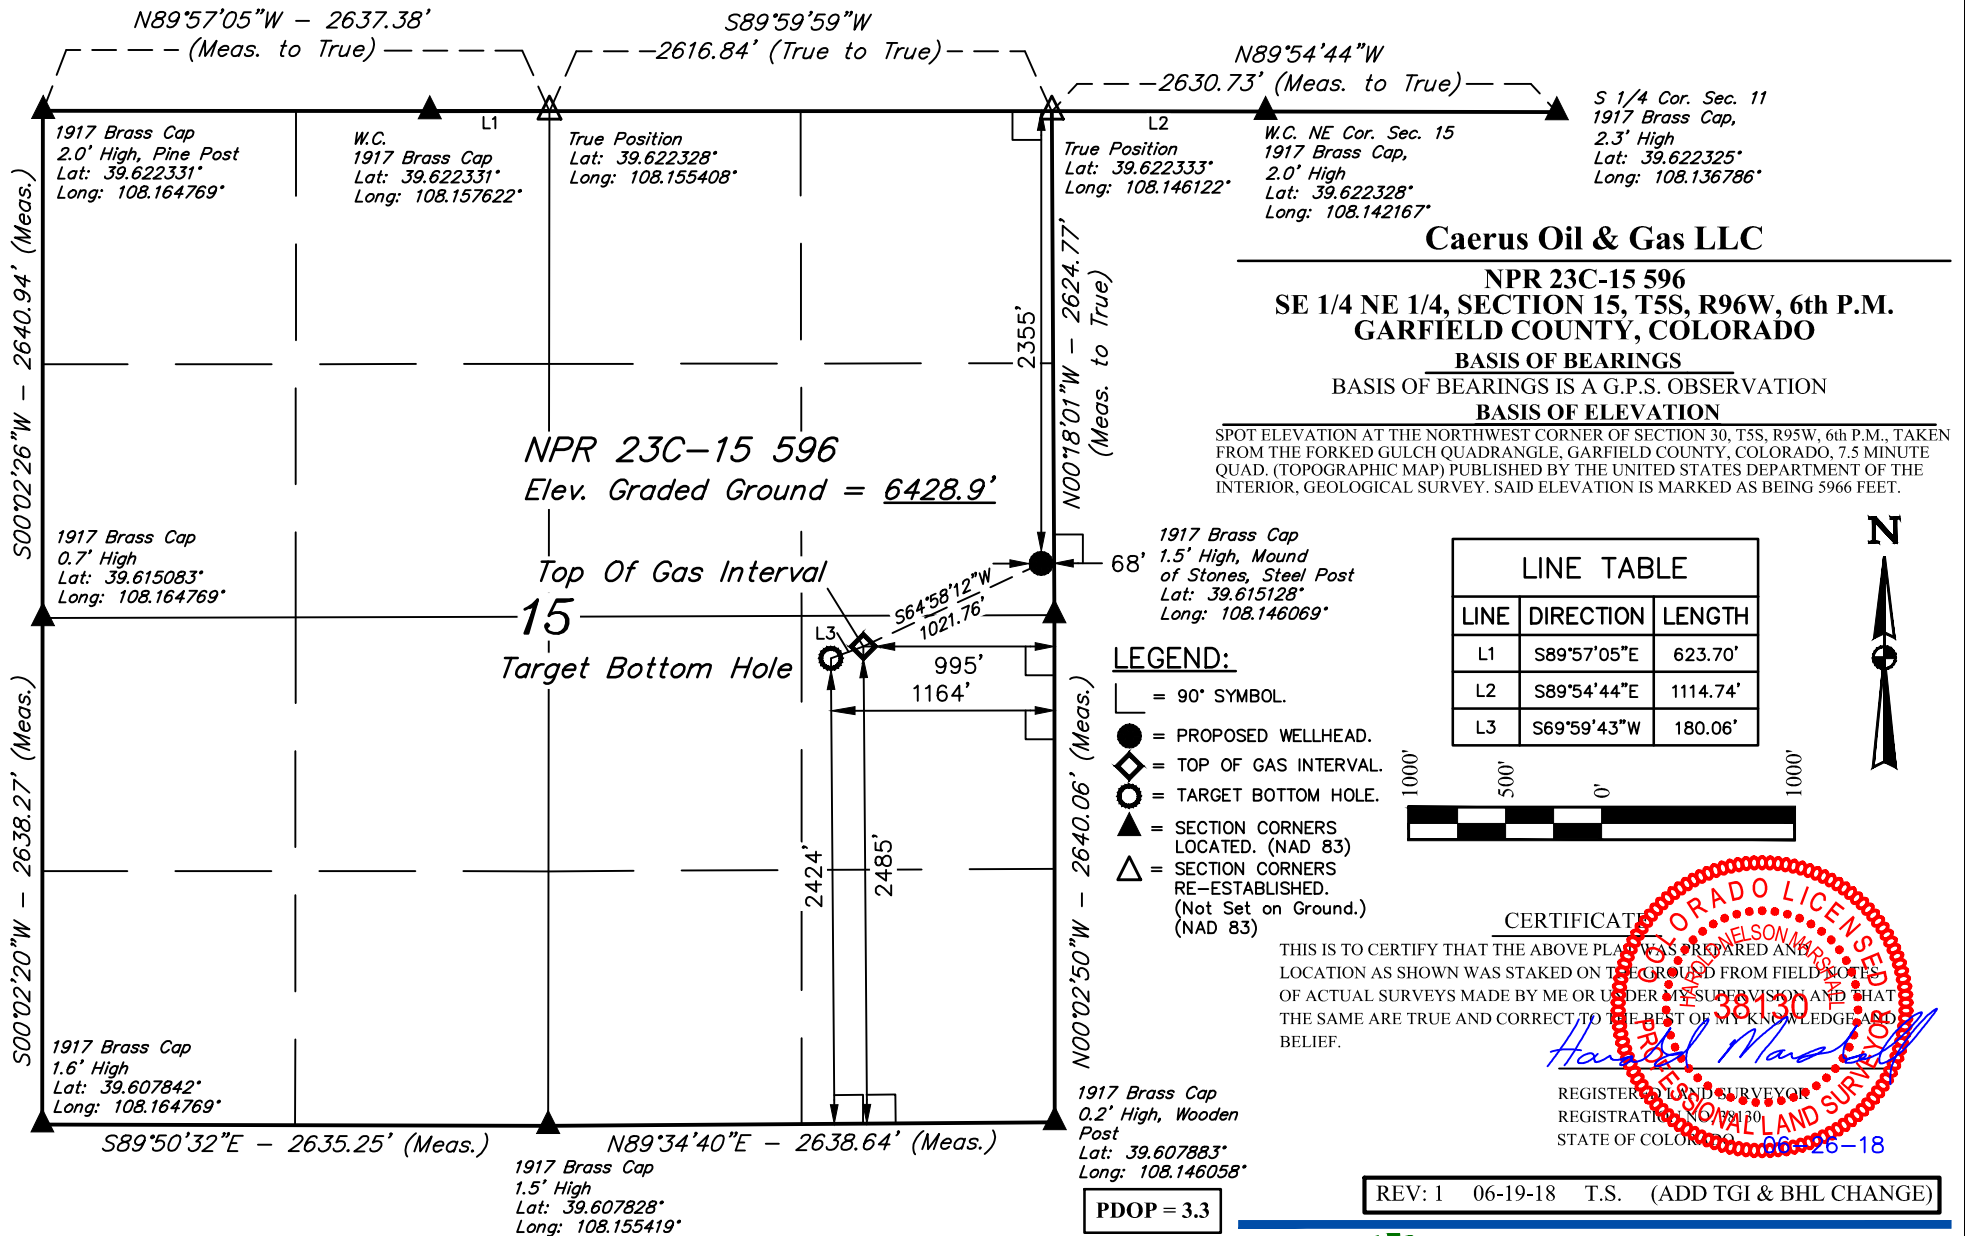

NAD 83 (SURFACE LOCATION)	NAD 83 (TOP OF GAS INTERVAL)	NAD 83 (TARGET BOTTOM HOLE)
LATITUDE = 39°36'57.13" (39.615869)	LATITUDE = 39°36'52.85" (39.614681)	LATITUDE = 39°36'52.24" (39.614512)
LONGITUDE = 108°08'46.73" (108.146314)	LONGITUDE = 108°08'58.56" (108.149600)	LONGITUDE = 108°09'00.72" (108.150200)
NAD 27 (SURFACE LOCATION)	NAD 27 (TOP OF GAS INTERVAL)	NAD 27 (TARGET BOTTOM HOLE)
LATITUDE = 39°36'57.21" (39.615892)	LATITUDE = 39°36'52.94" (39.614705)	LATITUDE = 39°36'52.33" (39.614536)
LONGITUDE = 108°08'44.45" (108.145681)	LONGITUDE = 108°08'56.27" (108.148964)	LONGITUDE = 108°08'58.43" (108.149564)
UTM NAD 27 (ZONE 12)	UTM NAD 27 (ZONE 12)	UTM NAD 27 (ZONE 12)
N: 14398956.39 E: 2444316.40	N: 14398494.49 E: 2443404.96	N: 14398427.47 E: 2443237.82



**UELS, LLC**  
 Corporate Office \* 85 South 200 East  
 Vernal, UT 84078 \* (435) 789-1017

SURVEYED BY	BART HUNTING, J.F.	08-28-17	SCALE
DRAWN BY	M.D.	09-21-17	1" = 1000'

**WELL LOCATION PLAT**