

R 97W

RECEIVED

MAY 15 1981

S89°52'E


COLO. OIL & GAS CONS. COMM.
2640.0'

Marked Stone




2256.5'

Location:
Amoco Federal
1-19
Grnd. Elev.:
7102.0

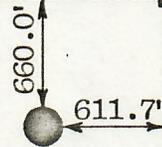

T11N

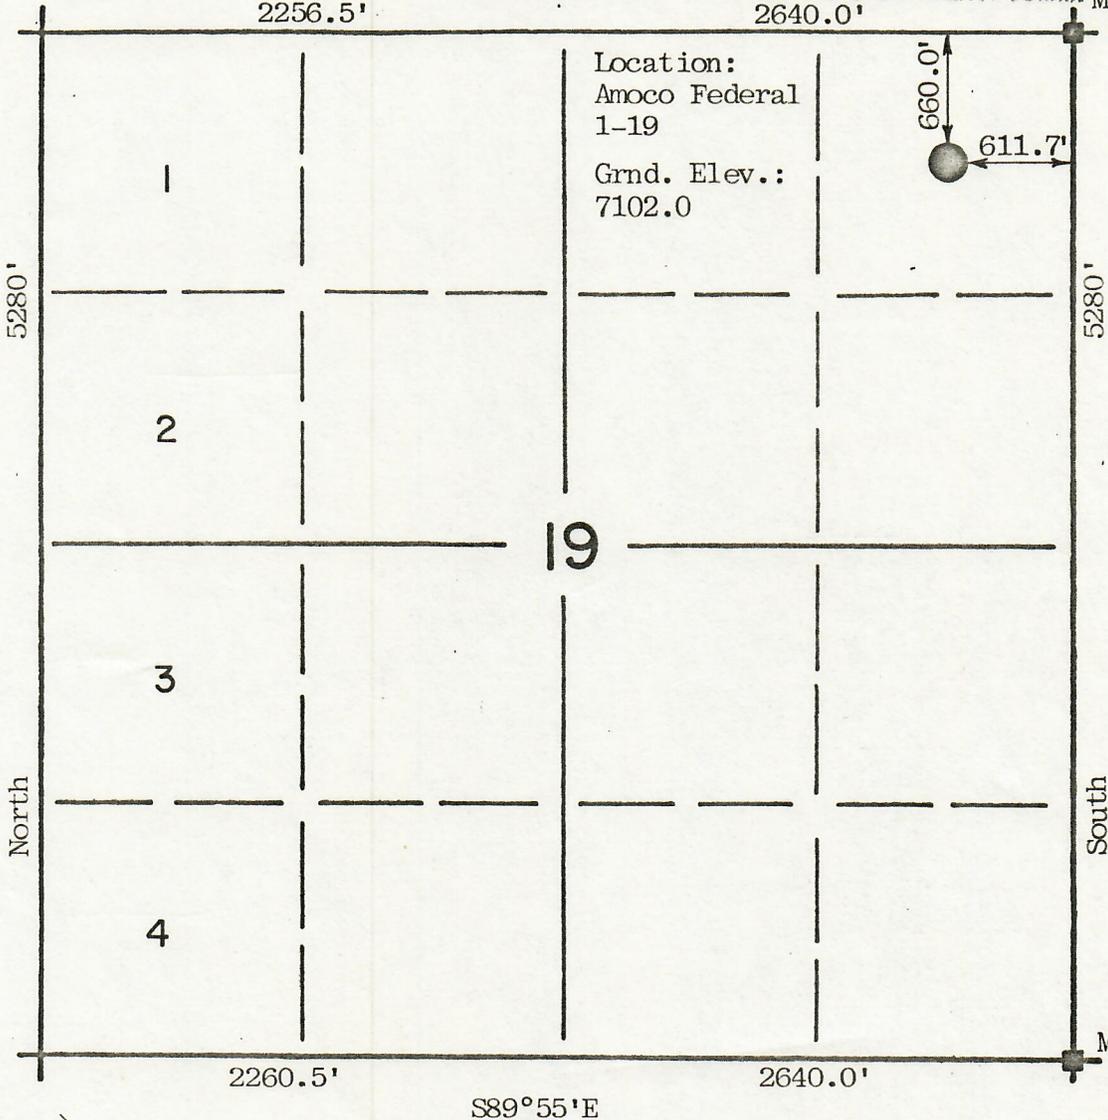

SURVEYOR'S CERTIFICATE

WELL LOCATION

I, Martin A. Pedersen of Rawlins, Wyoming, hereby certify that this map was made from notes taken on a survey made under my supervision by Les Lake on March 19, 1981, and that it correctly represents the location "Federal 1-19" as staked in the field.

Amoco Federal 1-19

FOR

Amoco Production Company

IN

NE $\frac{1}{4}$ NE $\frac{1}{4}$ Section 19, T11N, R97W

Moffatt County

Colorado

CO Reg. No. 12437 *Martin A. Pedersen*

- Ref. Point 200' North = 7086.9
- Ref. Point 200' South = 7119.3
- Ref. Point 200' East = 7096.1
- Ref. Point 200' West = 7098.8

Elevations are referred to the Northeast corner
Section 19 = 7034.40

ROBERT JACK SMITH & ASSOC.
CONSULTING ENGINEER & LAND SURVEYOR
RAWLINS, WYO.



00290492

Scale: 1" = 1000'

Map File No. 3807