



00016349


CERTIFICATE OF SURVEY
for
Snyder Drilling Co.
Morgan County, Colorado

RECEIVED

NOV 6 1972

COLD. CH. 2. 0. 0. 0. 0.

T1N R56W 6PM

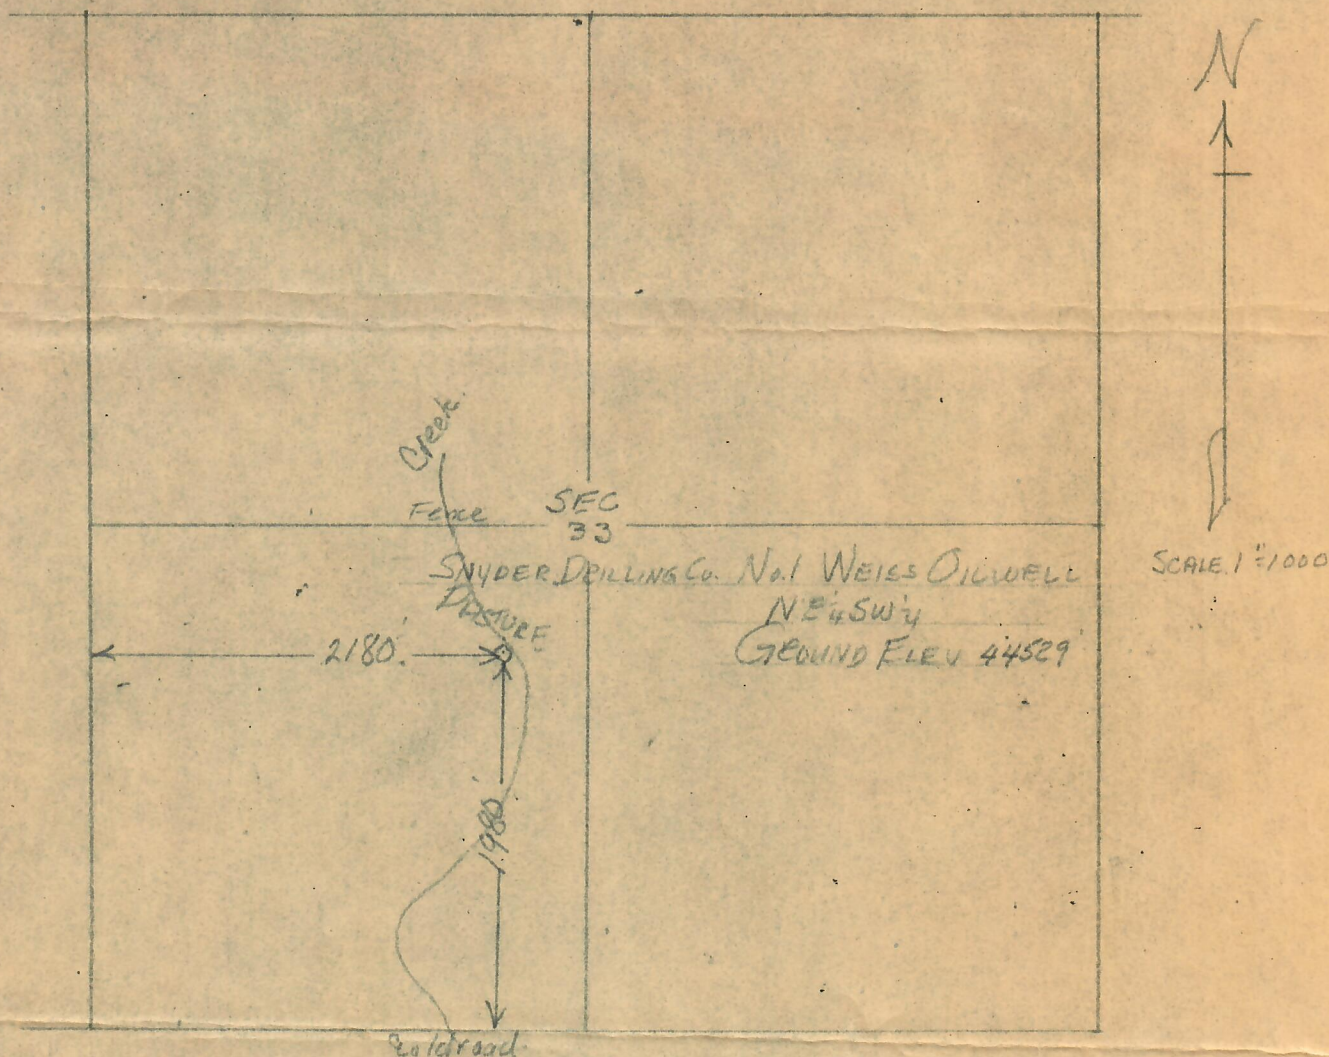

I hereby certify that the above plat is an accurate representation of a correct survey showing the location of Snyder Drilling Co.-No.1 Weiss Oilwell in NE 1/4 SW 1/4 Sec. 33 T1N R56W 6PM. The elevation of the ground at the stake is 4452.9 feet above sea level from U.S.C.&G. Bench Mark.

Fort Morgan, Colorado
Oct. 29, 1972

Leslie J. Osborne
Registered Professional Engineer
State of Colorado