

BEST IMAGE  
AVAILABLE

79-710


CERTIFICATE OF SURVEY  
for  
Patrick A. Doheny  
Washington County, Colorado

RECEIVED

JUL 27 1979

COLO. OIL & GAS CONS. COMM.

T2N R51W 6PM

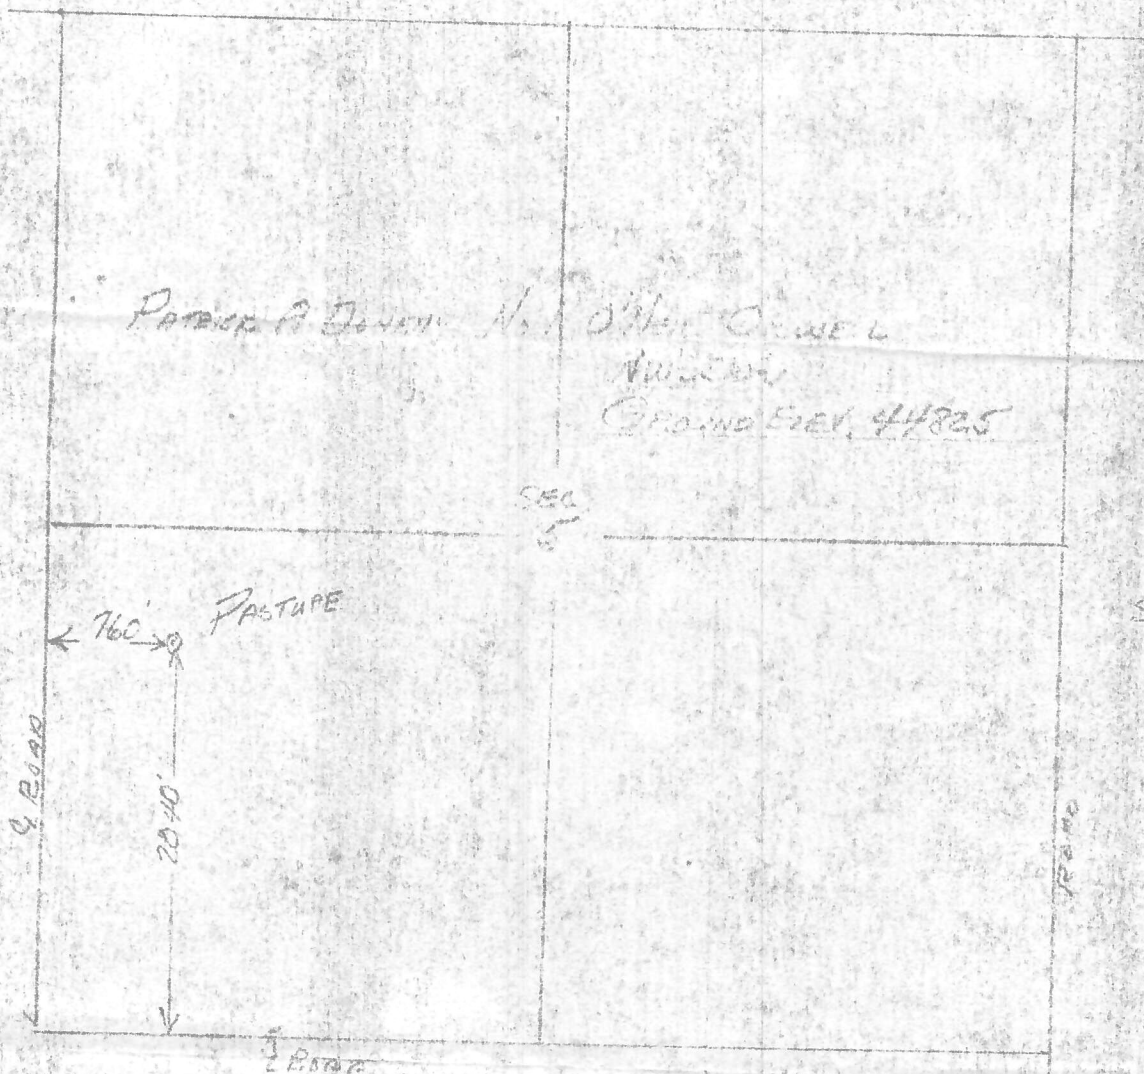

I hereby certify that the above plat is an accurate representation of a correct survey showing the location of Patrick A. Doheny-No.1 O'Neil Oilwell in NW 1/4 Sec. 5 T2N R51W 6PM. The elevation of the ground at the stake is 4482.5 feet above sea level from U.S.G.S. Bench Mark.

Fort Morgan, Colorado  
July 16, 1979

79. 710

Registered Professional Engineer  
State of Colorado

BEST COPY  
AVAILABLE



00075041