




CERTIFICATE OF SURVEY  
for  
Patrick A. Doherty  
Washington County, Colorado

Colo. Cons. Com.

RECEIVED  
JUL-1 1965

OIL & GAS  
CONSERVATION COMMISSION

T2N R5E W 6 PM.

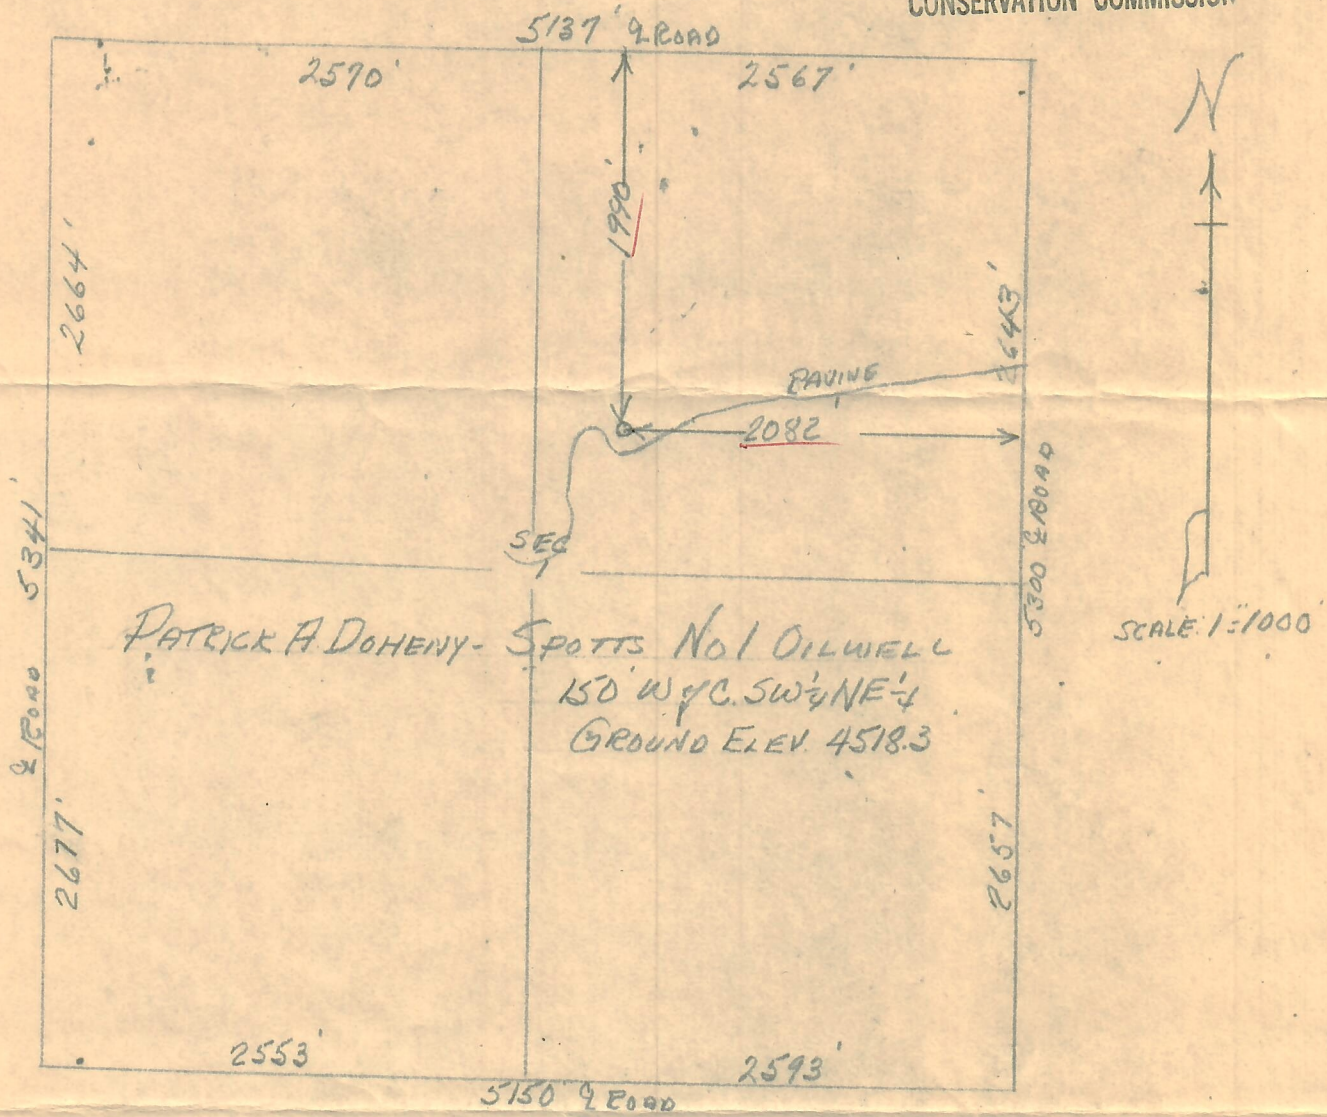

I hereby certify that the above plat is an accurate representation of a correct survey showing the location of Patrick A. Doherty - Spotts No. 1 Oilwell in Section 1 T2N R5E W 6 PM. The elevation of the ground at the stake is 4518.3 feet above sea level from U.S.C. & G. Bench Mark.

Fort Morgan, Colorado  
June 26, 1965

*Lacile J. Osborne*  
Registered Professional Engineer  
State of Colorado

65-252