



FORM F-106




00244898

RECEIVED

MAY 10 1972

R. 100 W.

COLO. OIL & GAS CONS. COMM.

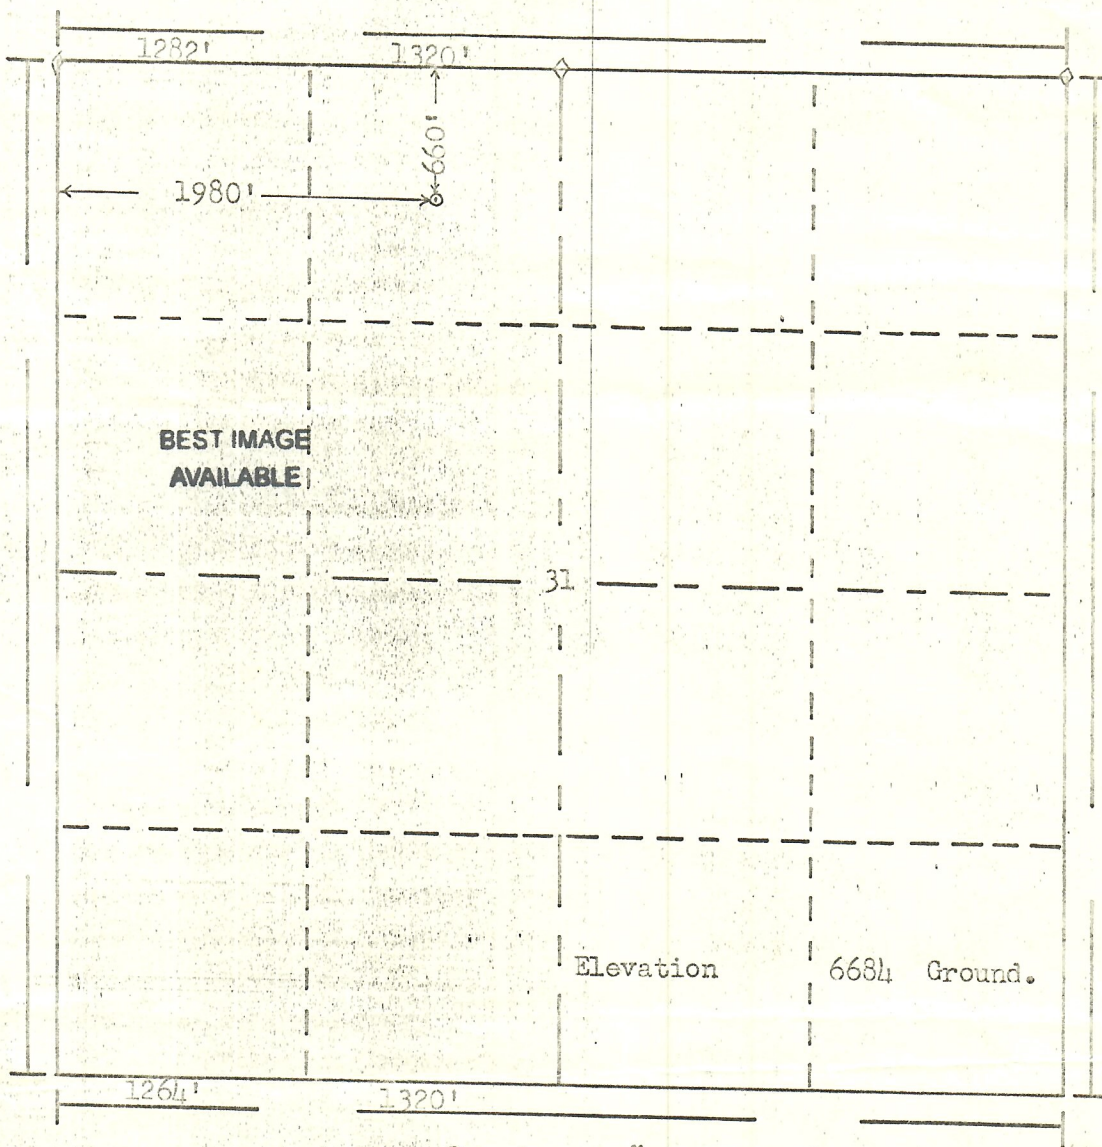

Scale... 1" = 1000'

Powers Elevation Company, Inc. of Denver, Colorado
has in accordance with a request from Curtis Clark
for

Tenneco Oil Company

determined the location of #1 Vermilion Creek

to be 660' FN & 1980' FW

Range 100 W. of the 6th Principal

Moffat

County,

Section 31 Township 11 N.

Meridian

Colorado

I hereby certify that this plat is an
accurate representation of a correct
survey showing the location of

#1 Vermilion Creek

Date: 5-5-72

Licensed Land Surveyor No. 1671
State of Colorado

72-268