BISON OIL & GAS

Current Wellbore Schematic

Well Name:	Melissa Compton 1	Date Prepared:	7/16/2018
Location:	1969' FSL, 689' FWL, NWSW Sec 17, T8N, R60W	Last Updated:	7/16/2018
County:	Weld	Spud Date:	2/4/1957
API #:	05-123-05562	Completion Start Date:	N/A
Co-ordinates:	40.66044 / -104.122364	Last Workover Date:	N/A
Elevations:	GROUND: 4946'	Prepared by:	Elizabeth Kane
	KB: 8'		
Depths (KB):	PBTD: --		
	TD: 7151'		

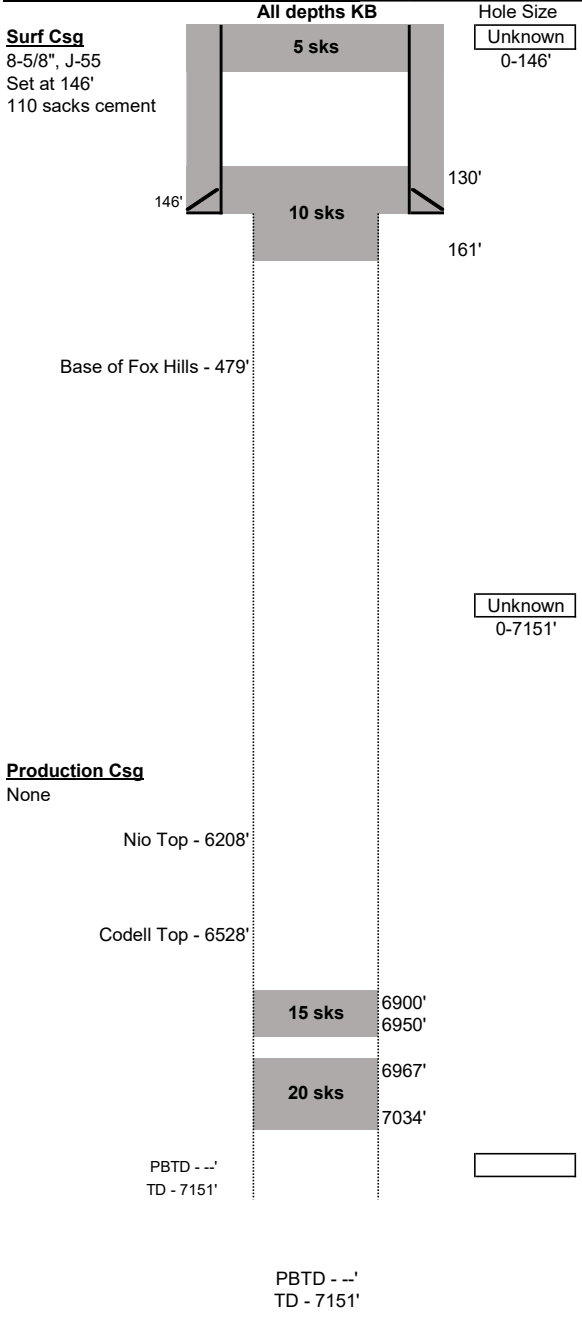

Surface Casing:
Landed 8-5/8", J-55 casing at 146'
Cemented with 110 sks

Production Casing:
No production casing

Open Hole:
146'-7151', hole size unknown, likely 7-7/8"

Tubing:
None

Rods:
None

Perforations:
None

P&A Plugs:
1. 5 sks at surface (0'-15')
2. 10 sks from 130'-161'
3. 15 sks from 6900'-6950'
4. 20 sks from 6967'-7034'

Additional Notes:

Initial Potential Test:

Formation Tops:

Fox Hills (base)	479'
Parkman	3375'
Shannon	5048'
Niobrara	6208'
Codell	6528'
D Sand	6956'
J Sand	7033'