




VERBAL REQUESTS

NOTICE OF INTENTION TO DRILL ✓

NOTICE OF INTENTION TO ABANDON _____

OTHER _____

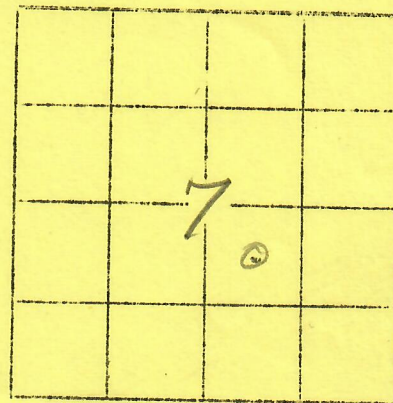

COMPANY Lion Oil

BY Joe Larkin

Title _____

LEASE Winger

WELL NUMBER 1

COUNTY Washington

FIELD Wildcat

LOCATION: BY QUARTERS NWSE Sec. 7 Twp. 2N R 52W Mer. 6th

The Well is located 1950 Ft. (N) of Section Line and 1980 Ft. (E) of section line. (S) (W)

DETAILS OF PLAN OF WORK: T.D. 4900' FORMATION Skull Creek

ESTIMATED DATE OF WORK: MI 5-9-55 A.M. _____ P. M. _____

138' - 8 5/8"
Skim hole -
Skull Creek test - 4900'

APPROVED BY: DV Rogers

DATE: 5-9-55

See ✓

✓