


CERTIFICATE OF SURVEY

Davis Oil Co.
Washington County, Colorado

BEST IMAGE
AVAILABLE

T2N R51W 6PM

5309' 2 ROAD

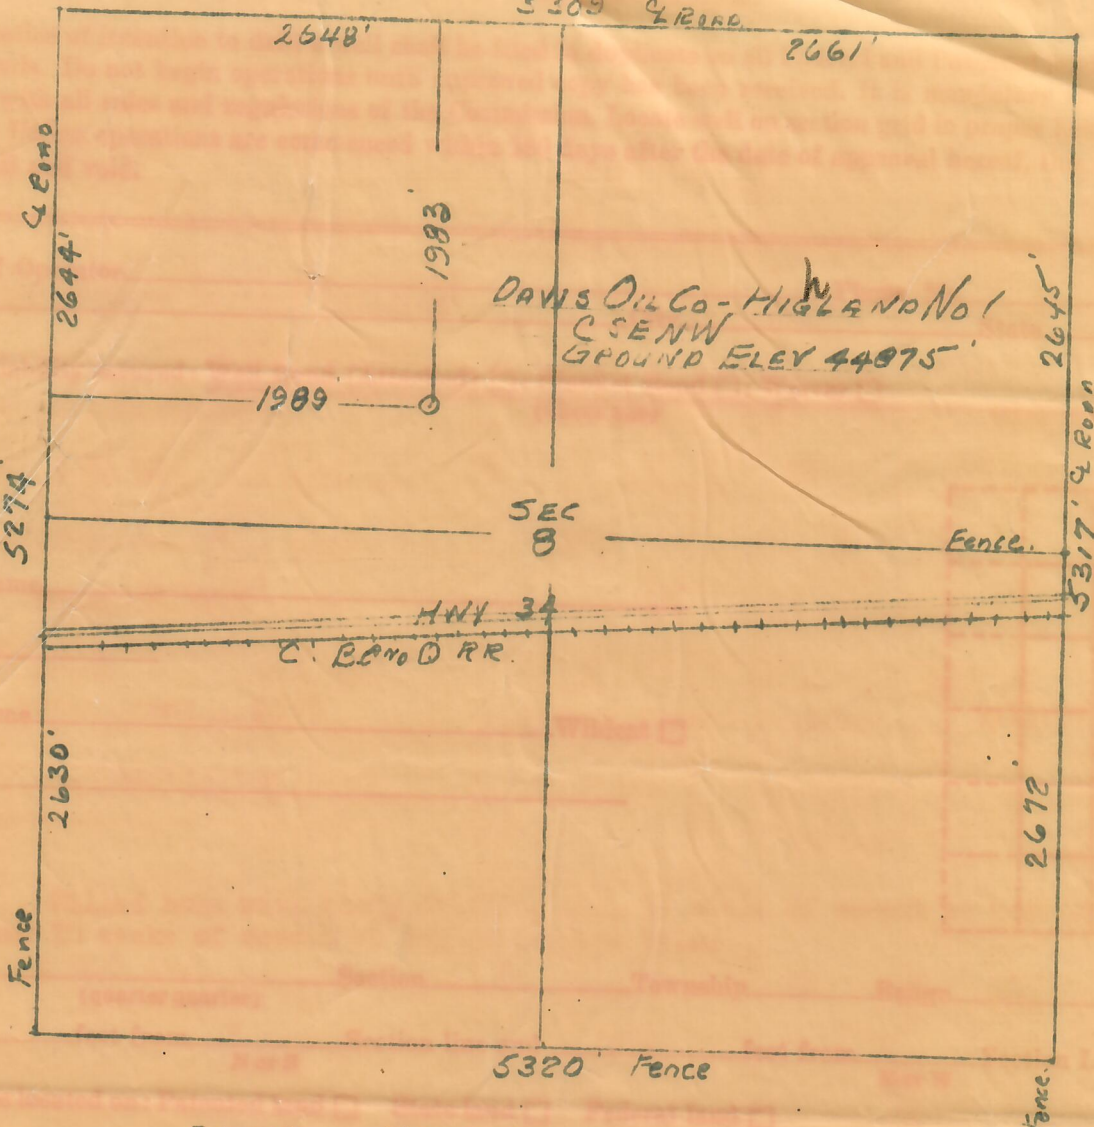

SCALE 1:1000

I hereby certify that the above plat is an accurate representation of a correct survey showing the location of Davis Oil Co.-Highland No.1 Oilwell in C SE 1/4 Sec. 8, T2N R51W 6PM. The elevation of the ground at the stake is 4487.5 feet above sea level from U.S.C.N. mark.

Fort Morgan, Colorado
July 12, 1957.

Registered Professional Engineer
State of Colorado

RECEIVED
JUL 16 1957

OIL & GAS
CONSERVATION COMMISSION