

DEC 20 1963


OIL & GAS  
COMMISSION



00789952

BEST IMAGE  
AVAILABLE

N

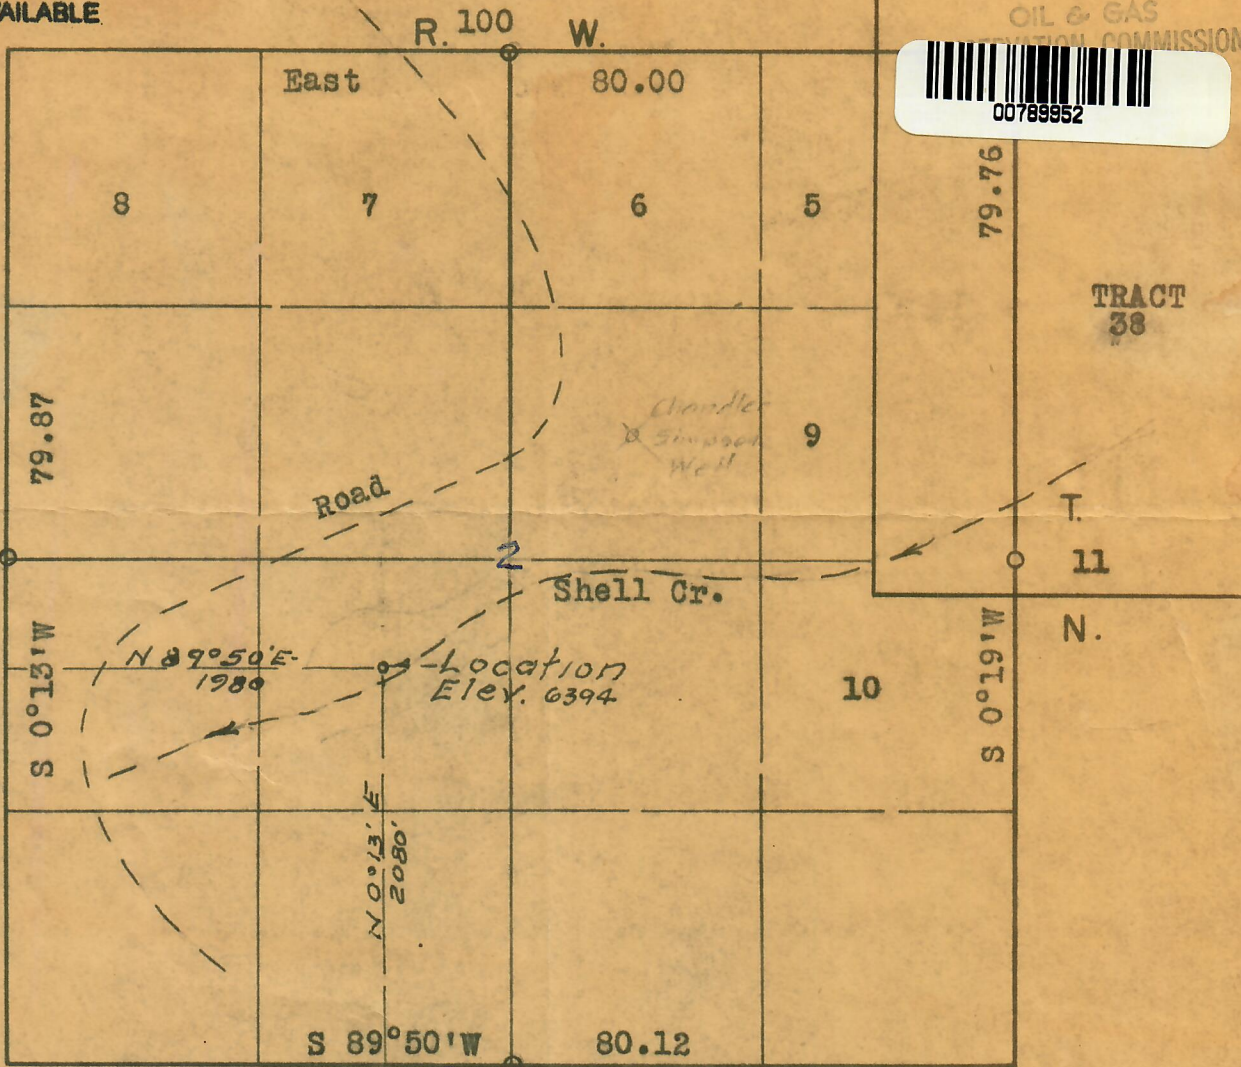

© Pipe Corner Found

MOFFATT COUNTY, COLORADO

CERTIFICATE OF SURVEYOR

MAP

State of Wyoming  
County of Sweetwater s.s.

SHOWING LOCATION OF  
TALAMENTAS CREEK UNIT, SHALLOW # 4

I, David P. Miller, of Rock Springs,  
Wyoming, do hereby certify that this  
map shows correctly the well location  
made for ~~xxx~~ PHILIP T. SHARPLES  
on December 11, 1963

SEC. 2 - T. 11 N. - R. 100 W.

PHILIP T. SHARPLES

Suite 1001, 1700 Broadway

Denver, Colorado

David P. Miller

P.E. - L.S. Reg. No. 133 (Wyoming)  
" " " " 1900 (Colorado)

Scale 1" = 1000'