


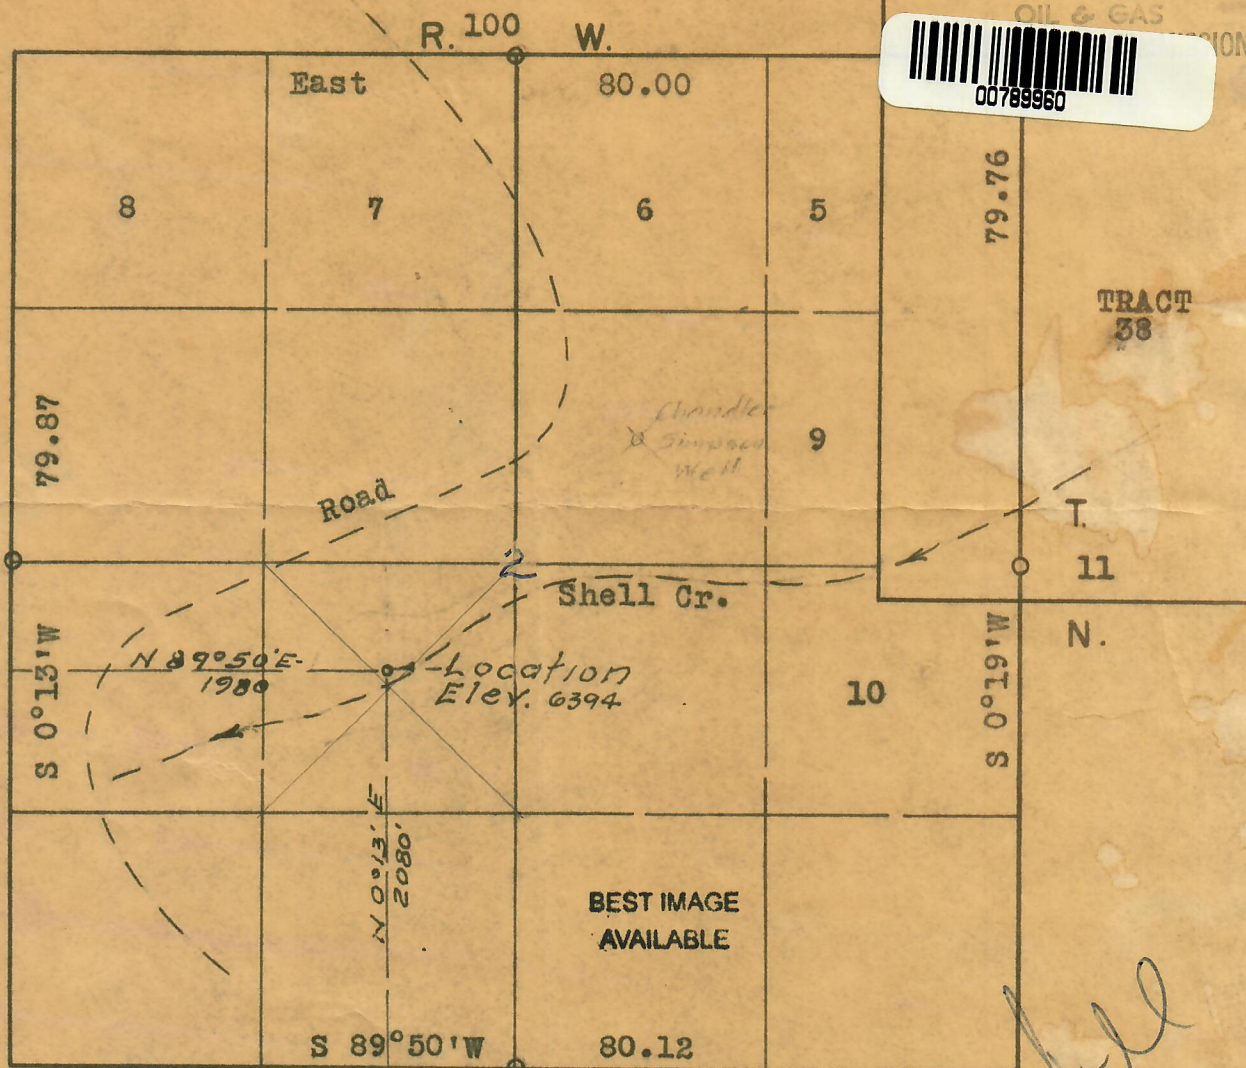

00789960




BEST IMAGE
AVAILABLE

© Pipe Corner Found

MOFFATT COUNTY, COLORADO

MAP

State of Wyoming
County of Sweetwater

SHOWING LOCATION OF
TALAMENTAS CREEK UNIT, SHALLOW # 4

I, David P. Miller, of Rock Springs, Wyoming, do hereby certify that this map shows correctly the well location made for ~~the~~ PHILIP T. SHARPLES on December 11, 1963

SEC. 2 - T.11 N. - R100 W.

PHILIP T. SHARPLES

Suite 1001, 1700 Broadway

Denver, Colorado

David P Miller

P.E. - L.S. Reg. No. 133 (Wyoming)

" " " " 1900 (Colorado)