

BEST IMAGE  
AVAILABLE

BEST IMAGE  
AVAILABLE


CERTIFICATE OF SURVEY  
for  
Allison Drilling Co.  
Washington County, Colorado

RECEIVED STATE

JUN - 3 1969

COLO. OIL & GAS CONS. COMM.

T2N R51W 6PM

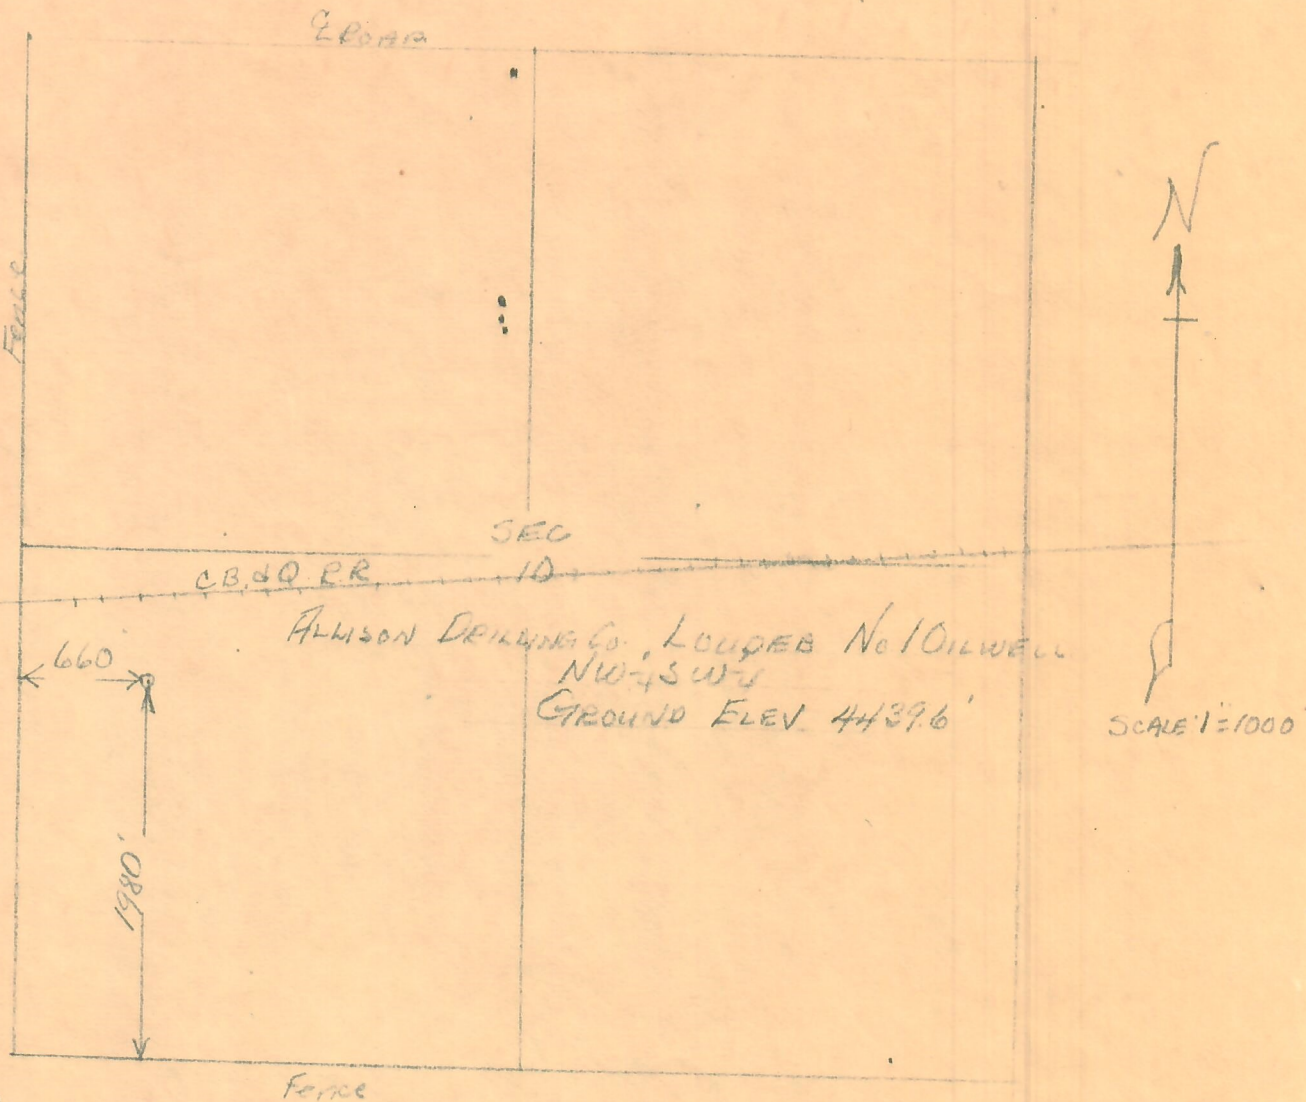

I hereby certify that the above plat is an accurate representation of a correct survey showing the location of Allison Drilling Co. - Louder No. 1 Oilwell in NW 1/4 SW 1/4 Sec. 10 T2N R51W 6PM. The elevation of the ground at the stake is 4439.6 feet above sea level from U.S.C&G. Bench Mark.

Fort Morgan, Colorado  
June 1, 1969

*Cecil J. Osborne*  
Registered Professional Engineer  
State of Colorado



69-253