


Surface  
Drainage

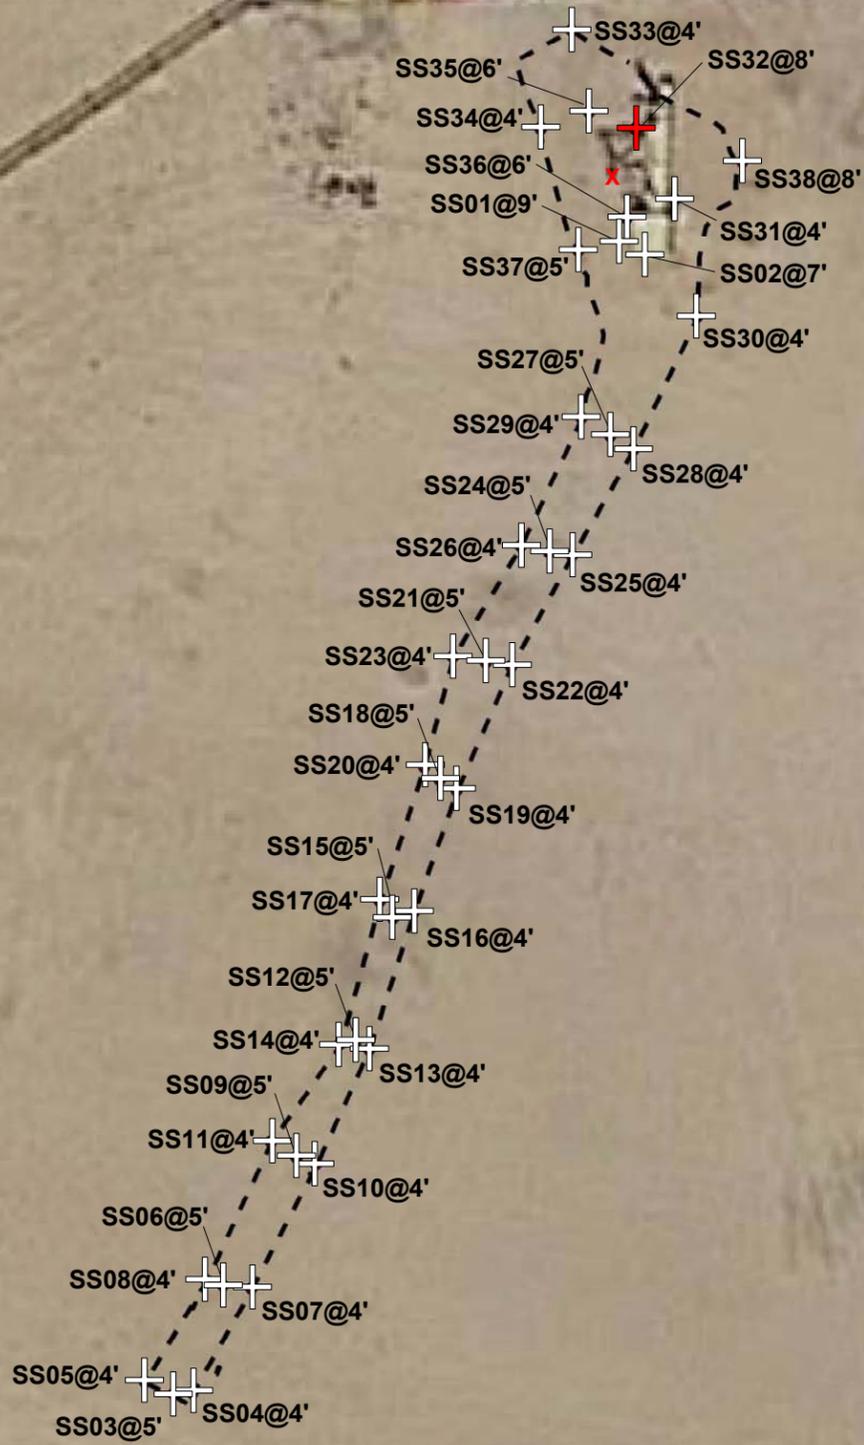

**Legend**

- Excavation Extent (Collected via Trimble GPS)
- Excavation Soil Sample Location (Collected via Trimble GPS)
- Excavation Soil Sample in Exceedance of COGCC Table 910 Standards (Collected via Trimble GPS)
- Point of Release

**Notes**

All locations are approximate unless otherwise noted.

Surface drainage direction is estimated based on topography and is not related to regional topography.

COGCC – Colorado Oil and Gas Conservation Commission

GPS – Global Positioning System

0 ft. 20 ft. 40 ft.

Image Source: Google Earth; 2016 Google  
Projection: WGS 84 UTM Zone 13 North

DATE: July 30, 2018

DESIGNED BY: C. Hamlin

DRAWN BY: C. Armbruster

**TASMAN**  
GEOSCIENCES

Tasman Geosciences, Inc.  
6899 Pecos Street – Unit C  
Denver, CO 80221

**PetroShare Corporation**  
**Former State of Colorado AB1 Tank Battery**  
SWNE, Section 16, Township 2 South, Range 66 West  
Adams County, Colorado

EXCAVATION SITE MAP  
(HISTORIC SEPARATOR  
RELEASE)

FIGURE  
1