


WELL LOCATION PLAT BIGHORN 4E-17H-P267

SE 1/4 SEC. 17, T2N, R67W, 6TH P.M.

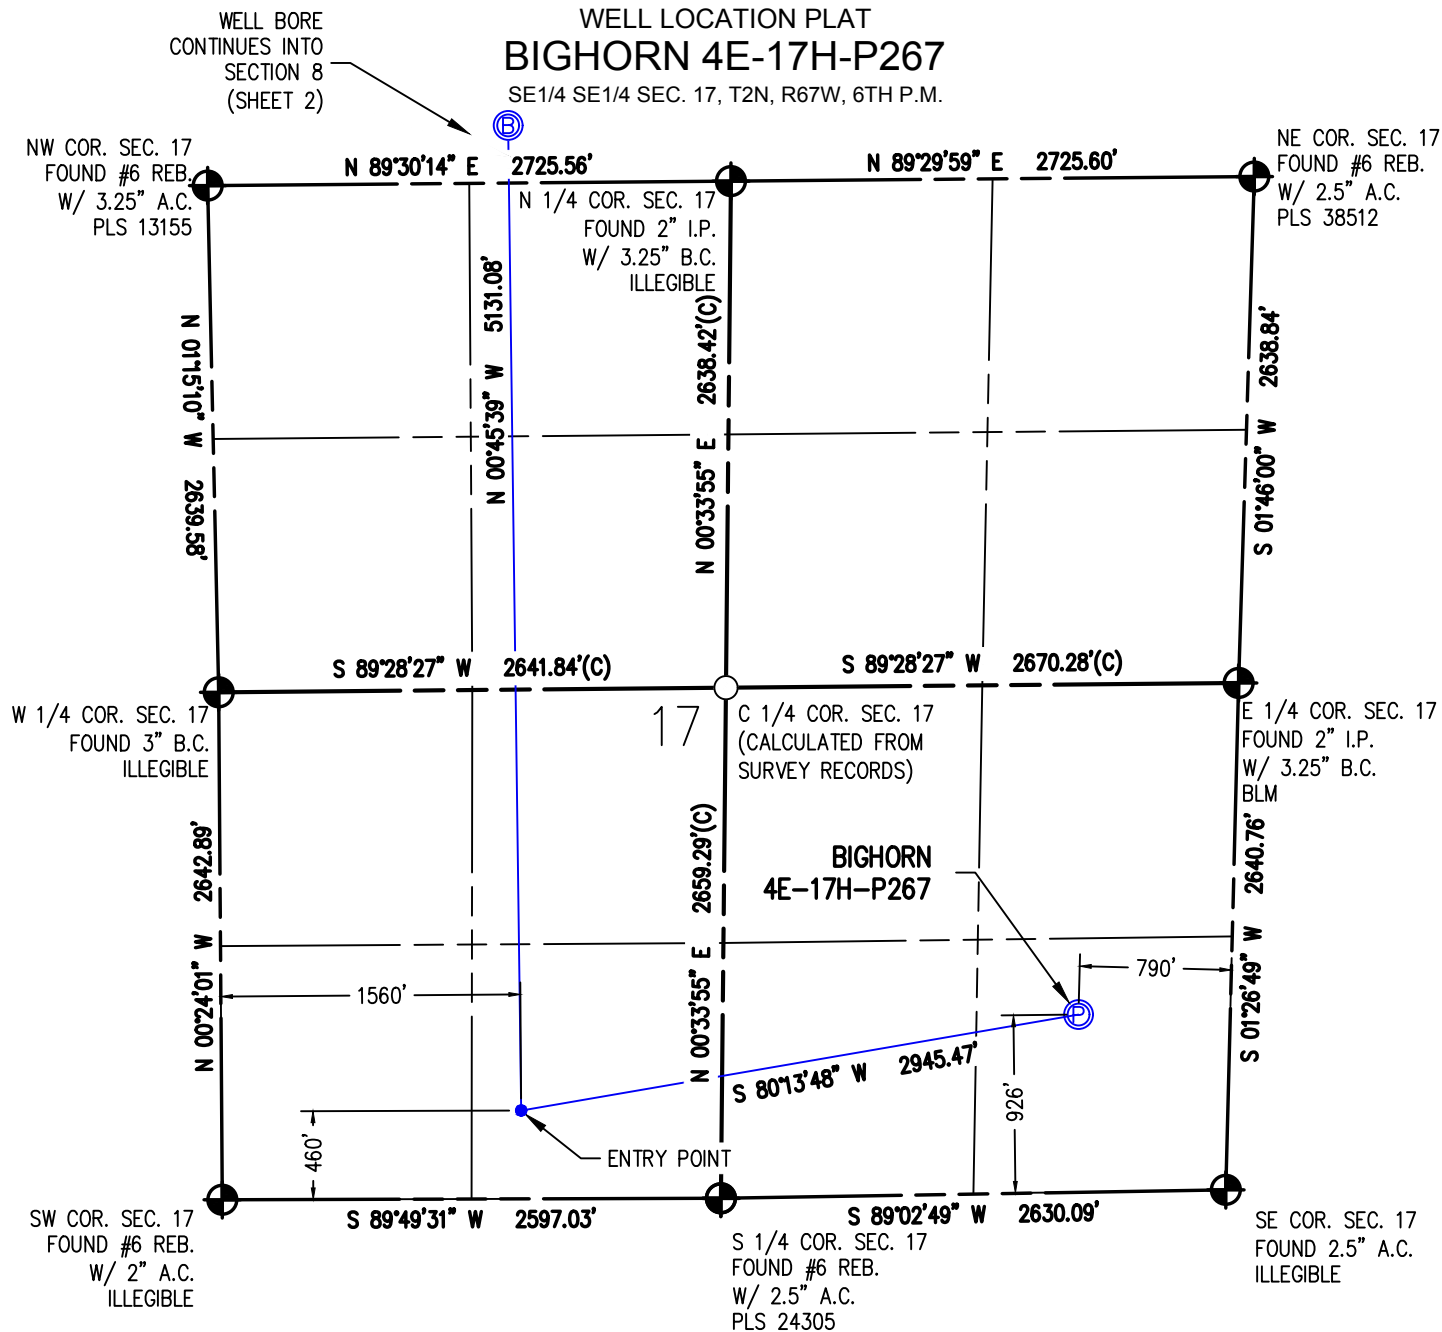

I HEREBY CERTIFY THAT THIS WELL LOCATION CERTIFICATE WAS PREPARED BY ME, OR UNDER MY DIRECT SUPERVISION, THAT THE FIELD WORK WAS COMPLETED ON 1/20/2018, THAT IT IS NOT A LAND SURVEY PLAT OR AN IMPROVEMENT SURVEY PLAT, AND THAT IT IS NOT TO BE RELIED UPON FOR ESTABLISHMENT OF FENCE, BUILDING OR OTHER FUTURE IMPROVEMENT LINES.

AARON A. DEMO
Professional Land Surveyor Registration No. 38285
State of Colorado
FOR AND ON BEHALF OF BASELINE ENGINEERING CORP.

N

0 1000'
Scale 1" = 1000' ft

SURFACE LOCATION
SEC. 17, T2N, R67W
GROUND ELEVATION = 4959.3'
PDOP = 1.2
LATITUDE = 40.133684°
LONGITUDE = -104.908019°
ENTRY POINT LOCATION
SEC. 17, T2N, R67W
LATITUDE = 40.132364°
LONGITUDE = -104.918412°
460' FSL, 1560' FWL
BOTTOM HOLE LOCATION
SEC. 8, T2N, R67W
LATITUDE = 40.146450°
LONGITUDE = -104.918536°
300' FSL, 1560' FWL

NOTES:


1. INDICATES SECTION CORNER
2. INDICATES CALCULATED CORNER
3. (C) INDICATES CALCULATED DIMENSION
4. ELEVATION BASED ON NAVD88 (GEOID12B)
5. BEARINGS DERIVED FROM COLORADO COORDINATE SYSTEM OF 1983 NORTH ZONE.
6. OPERATOR: TRAVIS WINNICKI
7. IMPROVEMENTS: SEE LOCATION DRAWING FOR ALL VISIBLE IMPROVEMENTS WITHIN 500' OF DISTURBED AREA.
8. WELL FOOTAGES ARE MEASURED AT RIGHT ANGLES TO THE SECTION LINES.

NEAREST CULTURAL ITEMS:


BUILDING: 761' SE
BUILDING UNIT: 972' NW
HIGH OCCUPANCY BUILDING UNIT: 5280'+
DESIGNATED OUTSIDE ACTIVITY AREA: 5280'+
PUBLIC ROAD: WELD COUNTY ROAD 20 906' S
ABOVE GROUND UTILITY: 948' S
RAILROAD: 5280'+
PROPERTY LINE: 322' S
SURFACE USE: NON-CROP LAND.
NEAREST EXISTING WELL: MILLER 3-17 568' NW



DRAWN BY	RPM	CHECKED BY	AAD
INITIAL SUBMITTAL	4/13/2018	REVISED	N/A
DRAWING SIZE	8.5" X 11"	JOB NO.	361A
SHEET	1 OF 2		

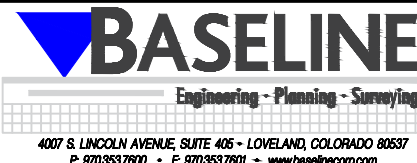

SE1/4 SE1/4 SEC. 17, T2N, R67W, 6TH P.M.



BASELINE
Engineering - Planning - Surveying
4007 S. LINCOLN AVENUE, SUITE 405 • LOVELAND, COLORADO 80537

PLOT_STAMP