
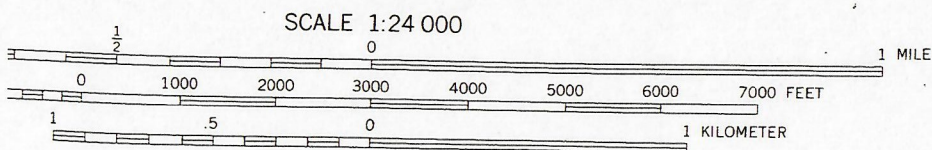


RECEIVED  
APR -7 00  
COGCC

T33S - R43W  
BACA COUNTY, COLORADO

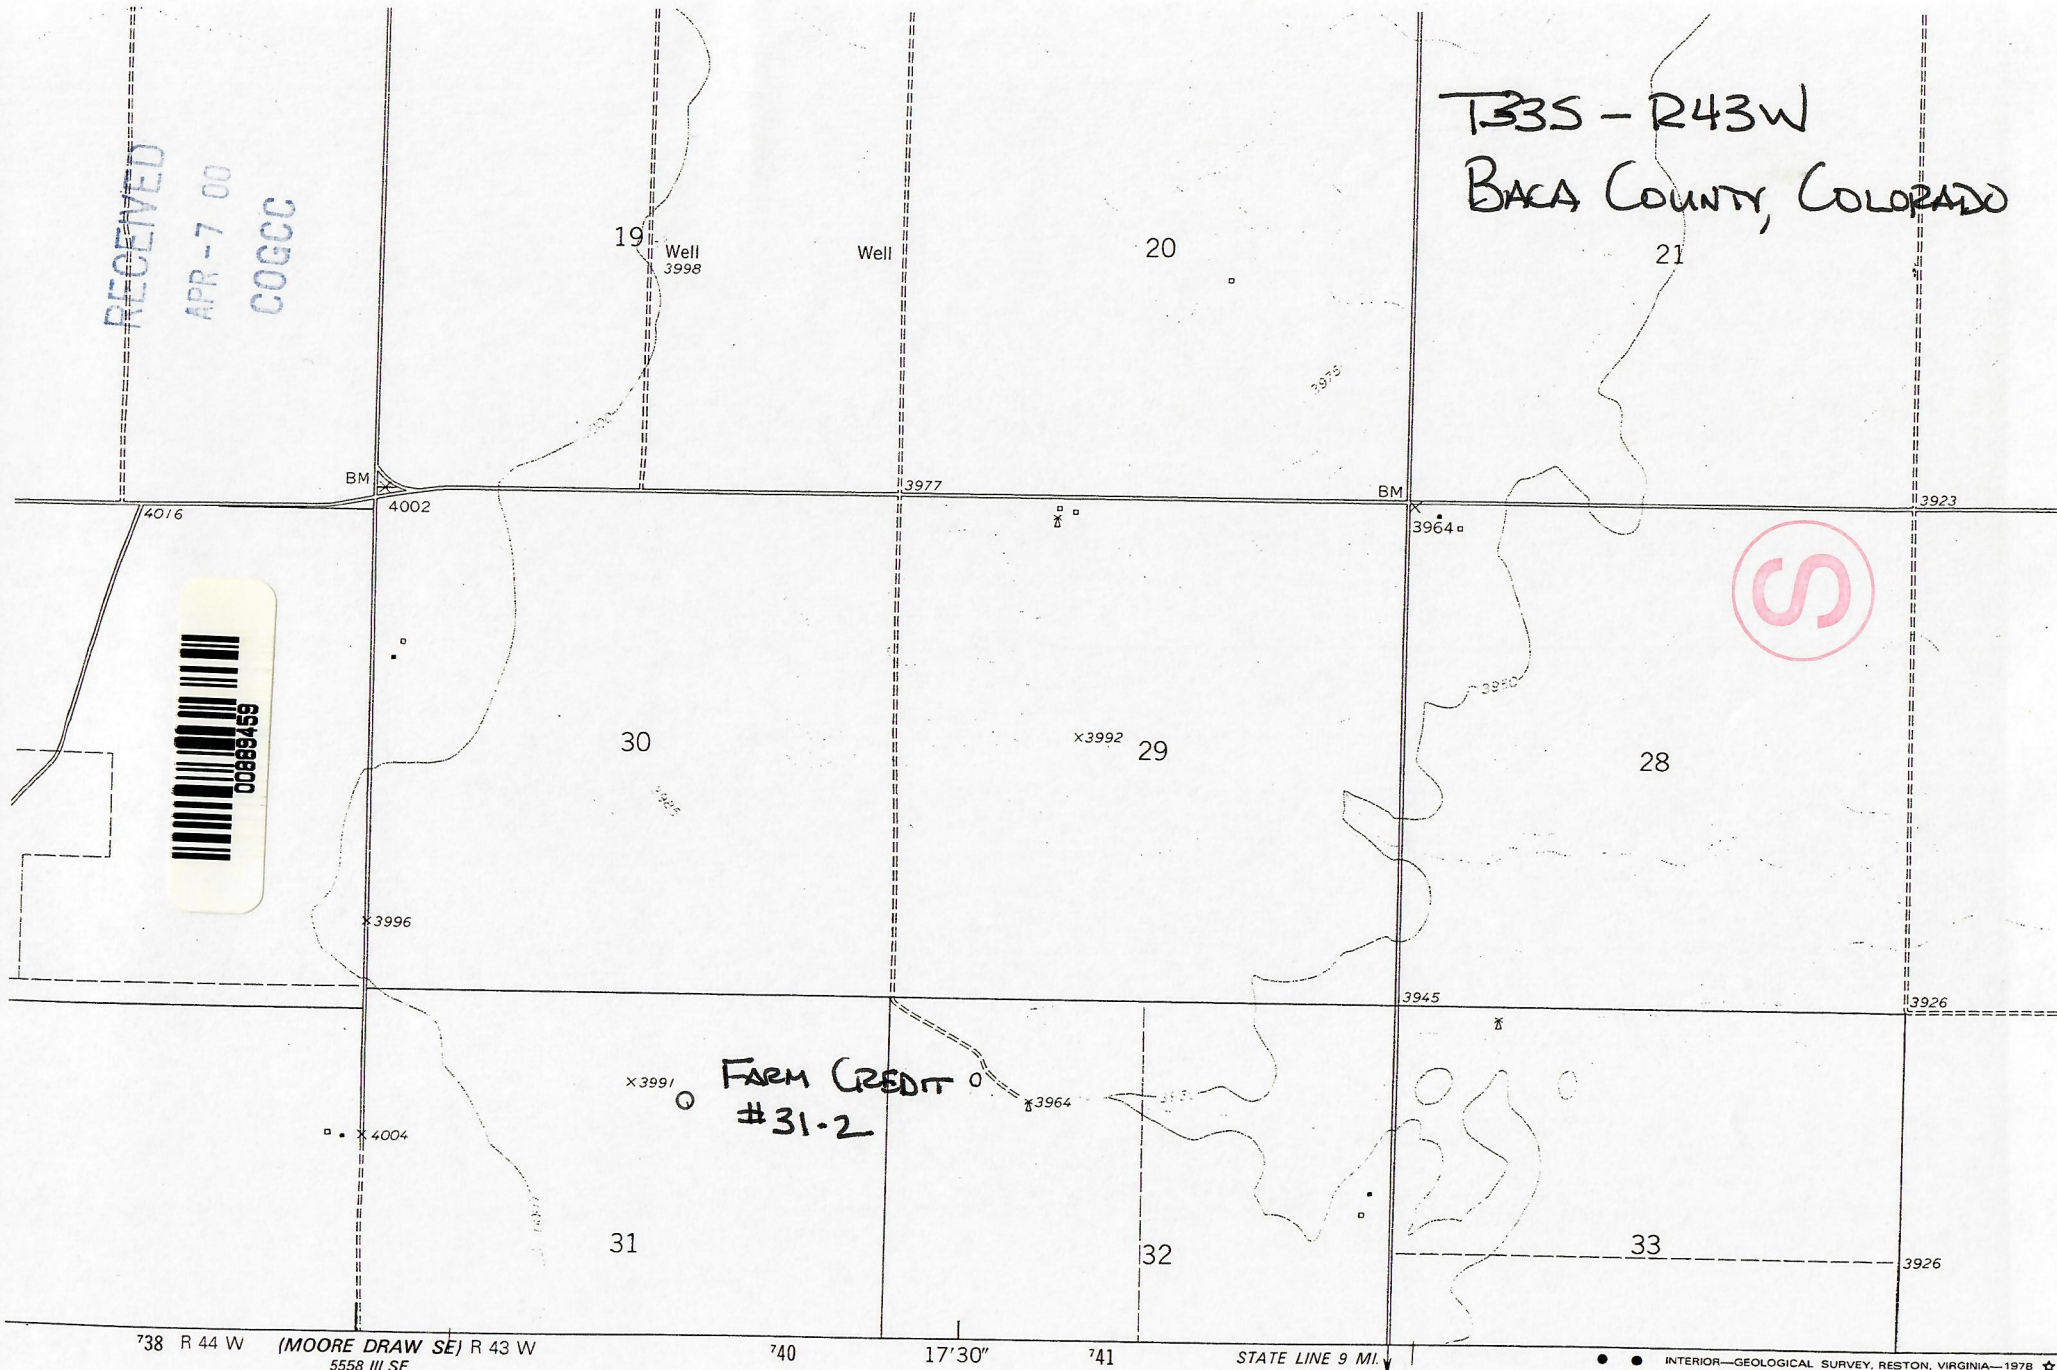

CONTOUR INTERVAL 10 FEET  
DOTTED LINES REPRESENT 5-FOOT CONTOURS

COLORADO

#### ROAD CLASSIFICATION

Primary highway, hard surface \_\_\_\_\_ Light-duty road, hard or improved surface \_\_\_\_\_  
Secondary highway, hard surface \_\_\_\_\_ Unimproved road \_\_\_\_\_

⬭ Interstate Route ⬭ U. S. Route ⬭ State Route