


Well Name: STATE 01


VERTICAL - ORIGINAL HOLE, 8/20/2018 4:08:07 PM

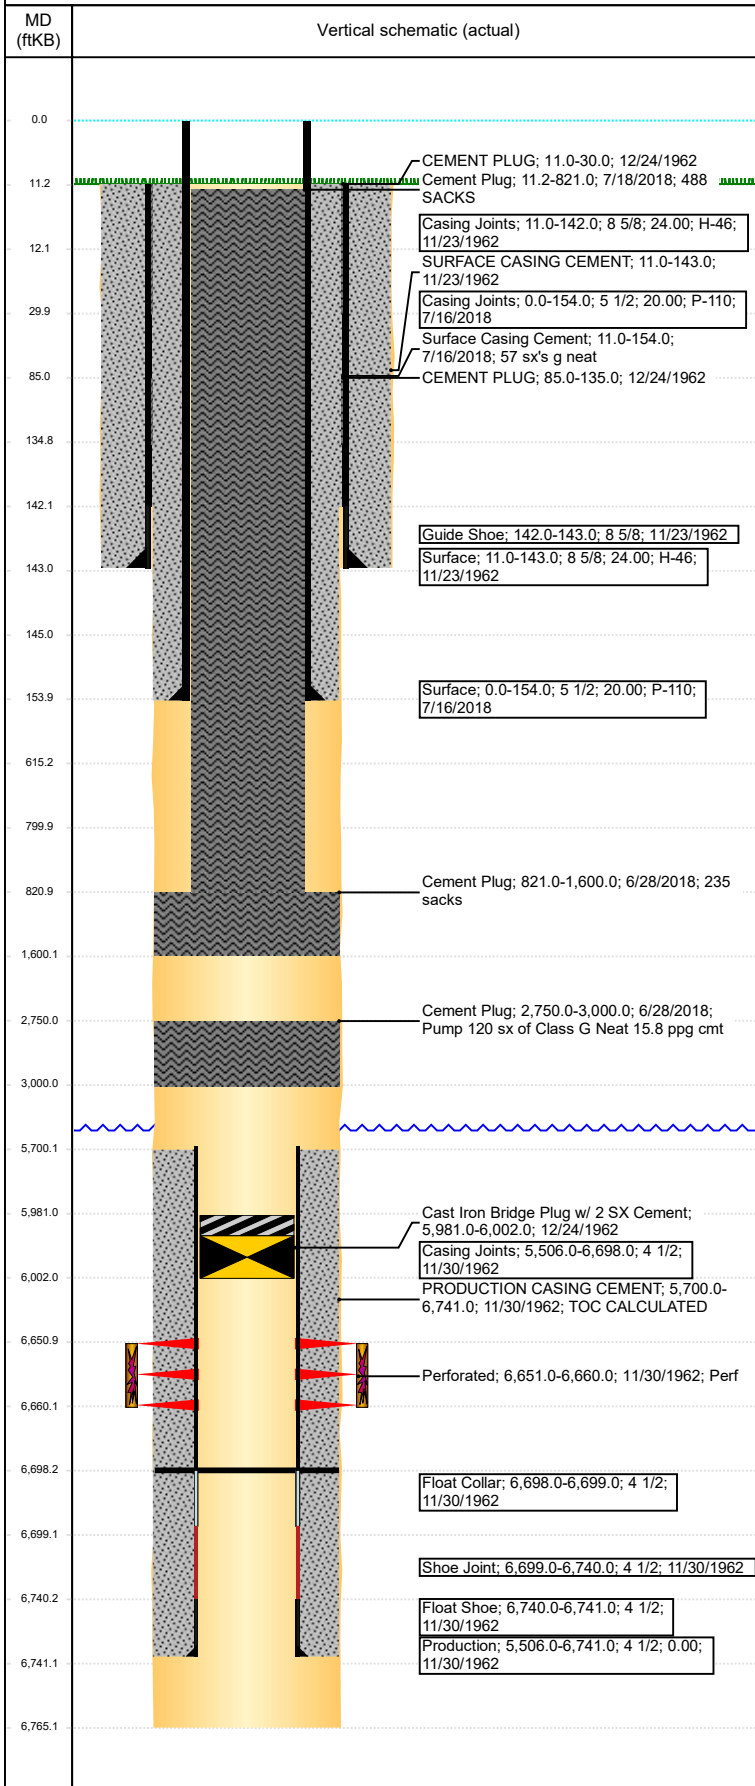

Well Header			
API 05-123-06149	Business Unit DJ BASIN	District 15	Well Config VERTICAL
Original KB Elevation (ft) 4,857	KB - GL / MSL (ftKB) 11.00	Spud Date 11/23/1962	P & A Date 7/18/2018
Comment ASSUMED 12 1/4" SURFACE HOLE, 7 7/8" PROD HOLE.			
4.5" PROD CASING IS BOTH 10.5# & 11.6#			
STRING SHOT CASING @ 5506' DURING P&A			
Directions To Well HWY 14 & CR115 NORTH ON 115 2 MILES WEST INTO			
Congressional Location			
Quarter 3 SW	Quarter 4 SE	Section 16	Township 5
Twntshp N/S Dir N	Range 66	Range E/W Dir W	
Bottom Hole Location			
North-South Distance (ft)	From N or S Line	East-West Distance (ft)	From E or W Line
Plug Back Total Depths			
Date 11/30/1962	Depth (ftKB) 6,698.0	Method CASING TALLY	Com STATE REPORTED PBTD
Wellbore Sections			
Section Des	Size (in)	Act Top, MD (ftKB)	Act Btm, MD (ftKB)
SURFACE	12 1/4	11	143
PRODUCTION	7 7/8	143	6,765
Zone Statuses			
Zone Name	Status Date	Status	Fluid Type
D SAND	12/24/1962	P&A	PLUG AND AB...
Casing Strings			
Surface, 143.0ftKB			
Casing Description	Run Date	OD (in)	Wt/Len (l...)
Surface	11/23/1962	8 5/8	24.00
Grade	Top, MD (ft...)	MD (ftKB)	
H-46	11.0	143.0	
Surface, 154.0ftKB			
Casing Description	Run Date	OD (in)	Wt/Len (l...)
Surface	7/16/2018	5 1/2	20.00
Grade	Top, MD (ft...)	MD (ftKB)	
P-110	0.0	154.0	
Production, 6,741.0ftKB			
Casing Description	Run Date	OD (in)	Wt/Len (l...)
Production	11/30/1962	4 1/2	
Grade	Top, MD (ft...)	MD (ftKB)	
	11.0	6,741.0	
Cement			
Description	Top Depth (ftKB)	Bottom Depth (ftKB)	
SURFACE CASING CEMENT	11.0	143.0	
PRODUCTION CASING CEMENT	5,700.0	6,741.0	
CEMENT PLUG	85.0	135.0	
CEMENT PLUG	11.0	30.0	
Cement Plug	821.0	1,600.0	
Cement Plug	2,750.0	3,000.0	
Cement Plug	615.0	1,600.0	
Cement Plug	143.0	800.0	
Cement Plug	12.0	143.0	
Surface Casing Cement	11.0	154.0	
Cement Plug	11.2	821.0	
Tubing Strings			
Tubing Description	Run Date	String...	ID (in)
Wt (lb/ft)	Grade	Len (ft)	Set De...
Other In Hole			
Run Date	Des	OD (in)	Top (ftKB)
12/24/1962	Cast Iron Bridge Plug w/ 2 SX Cement	3.99	5,981.0
12/24/1962	Rock Bridge	8.09	135.0
Logs			
Date	Type	Top, MD (ftKB)	Btm, MD (ftKB)

Well Name: STATE 01

VERTICAL - ORIGINAL HOLE, 8/20/2018 4:08:08 PM

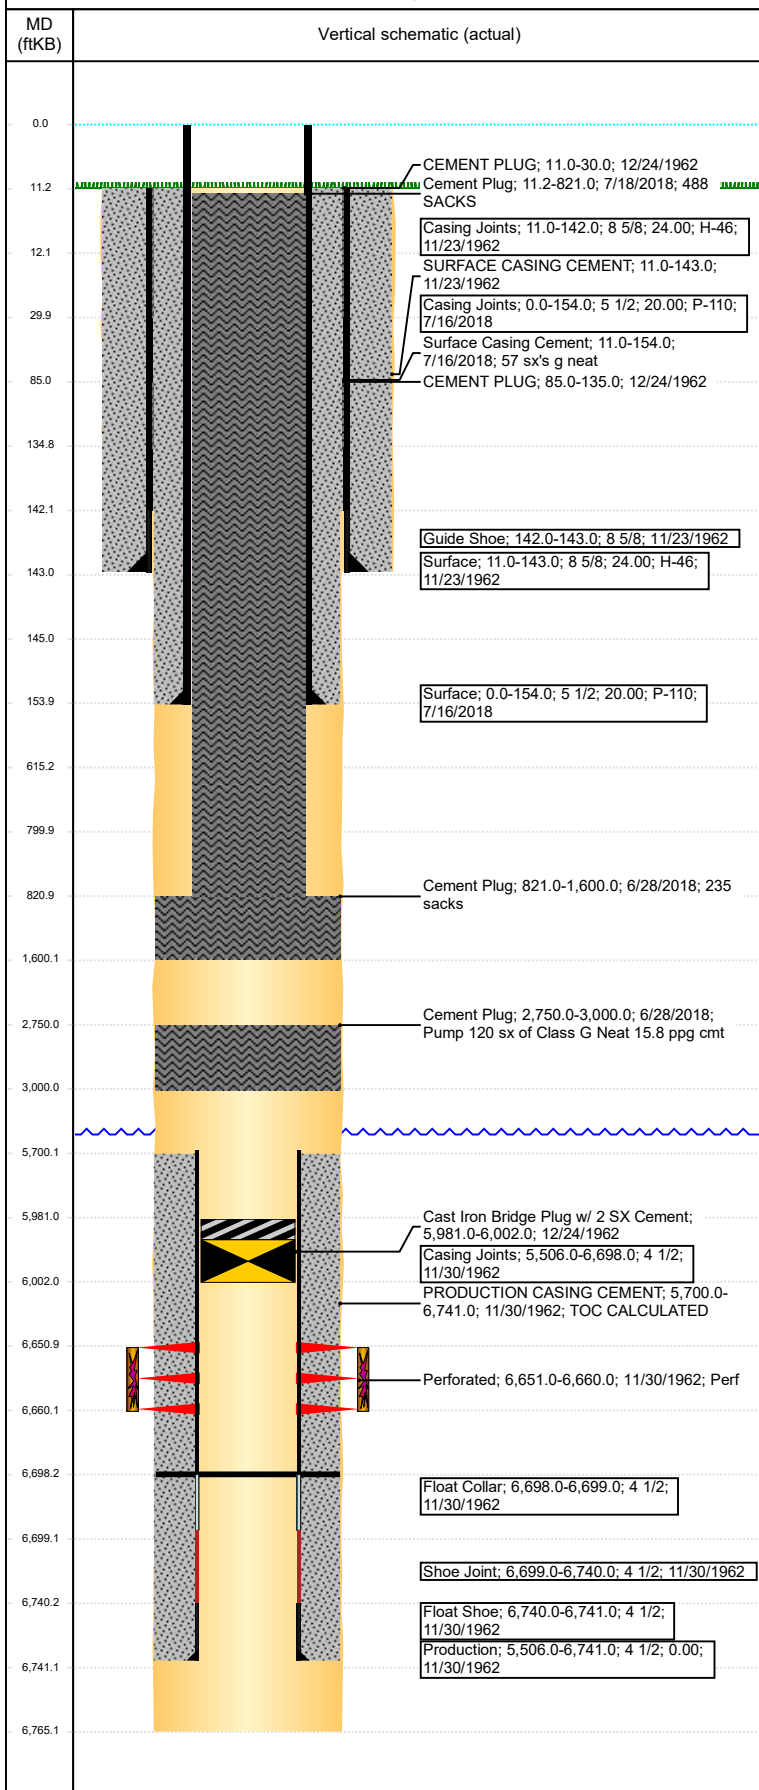

Perforation Data					
Linked Zone	Bnch/St g	Sum of Entered Shot Total	Top (ftKB)	Btm (ftKB)	Date
D SAND, ORIGINAL HOLE		0	6,651.00	6,660.00	11/30/1962
Total (Sum)		0			
Stimulation Intervals					
Start Date 12/1/1962		Primary Job Type COMPLETION - ORIGINAL			
Technical Result		Tech Result Details		Tech Result Note	
Comment					