




DRILLING COMPANY, INC.
WICHITA, KANSAS

Current Wellbore Diagram

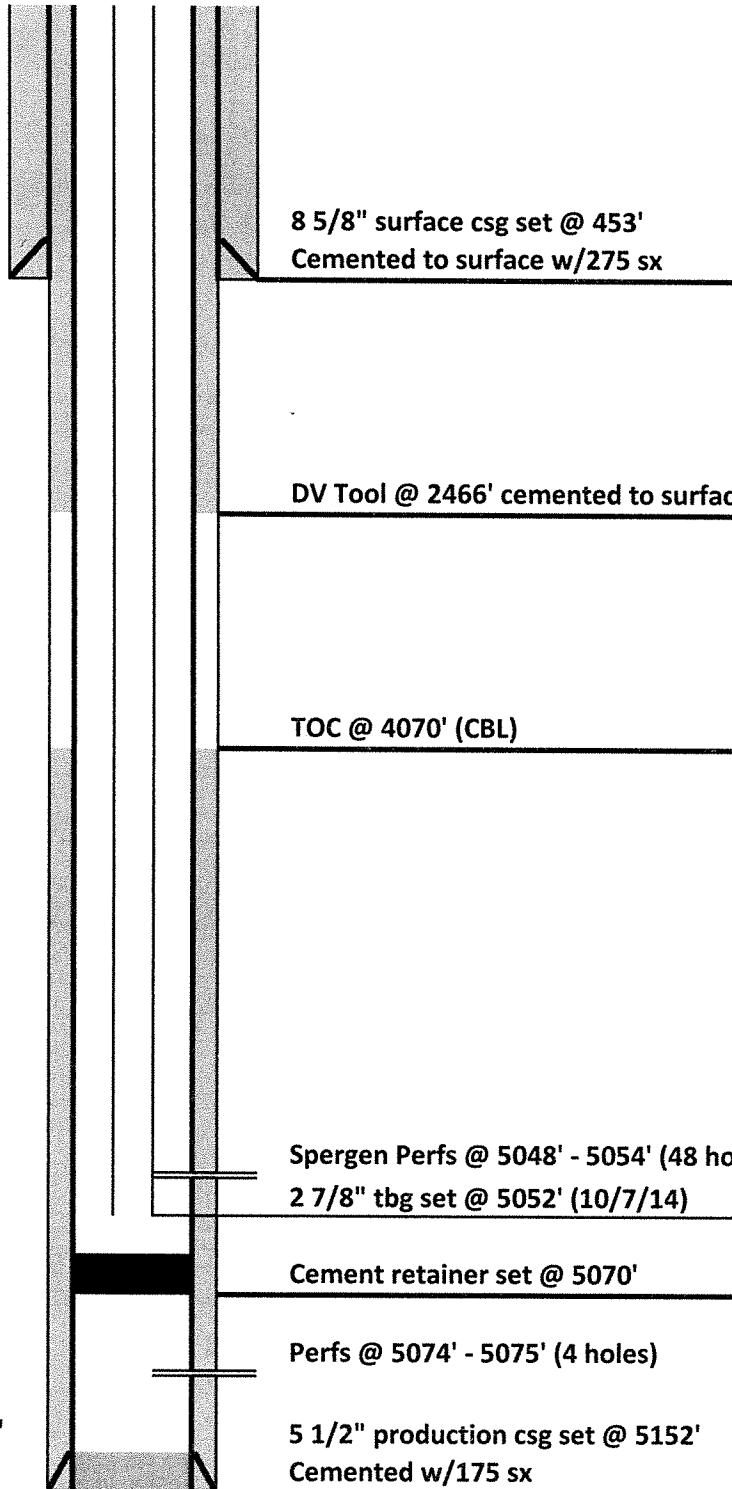

| | |
|----------------|---------------------|
| Date: | 3/18/2016 |
| Well Name: | Quiver Unit #4 |
| Old Well Name: | Pattie #1-2 |
| Location: | 600' FSL & 600' FEL |
| | SE/4 SE/4 2-17S-48W |
| County: | Kiowa |
| State: | Colorado |
| API: | 05-061-06762 |
| GL: | 4160' |
| KB: | 4171' |
| Spud Date: | 7/25/2000 |