


Well Name: STATE 0-1

VERTICAL - ORIGINAL HOLE, 8/20/2018 4:23:38 PM

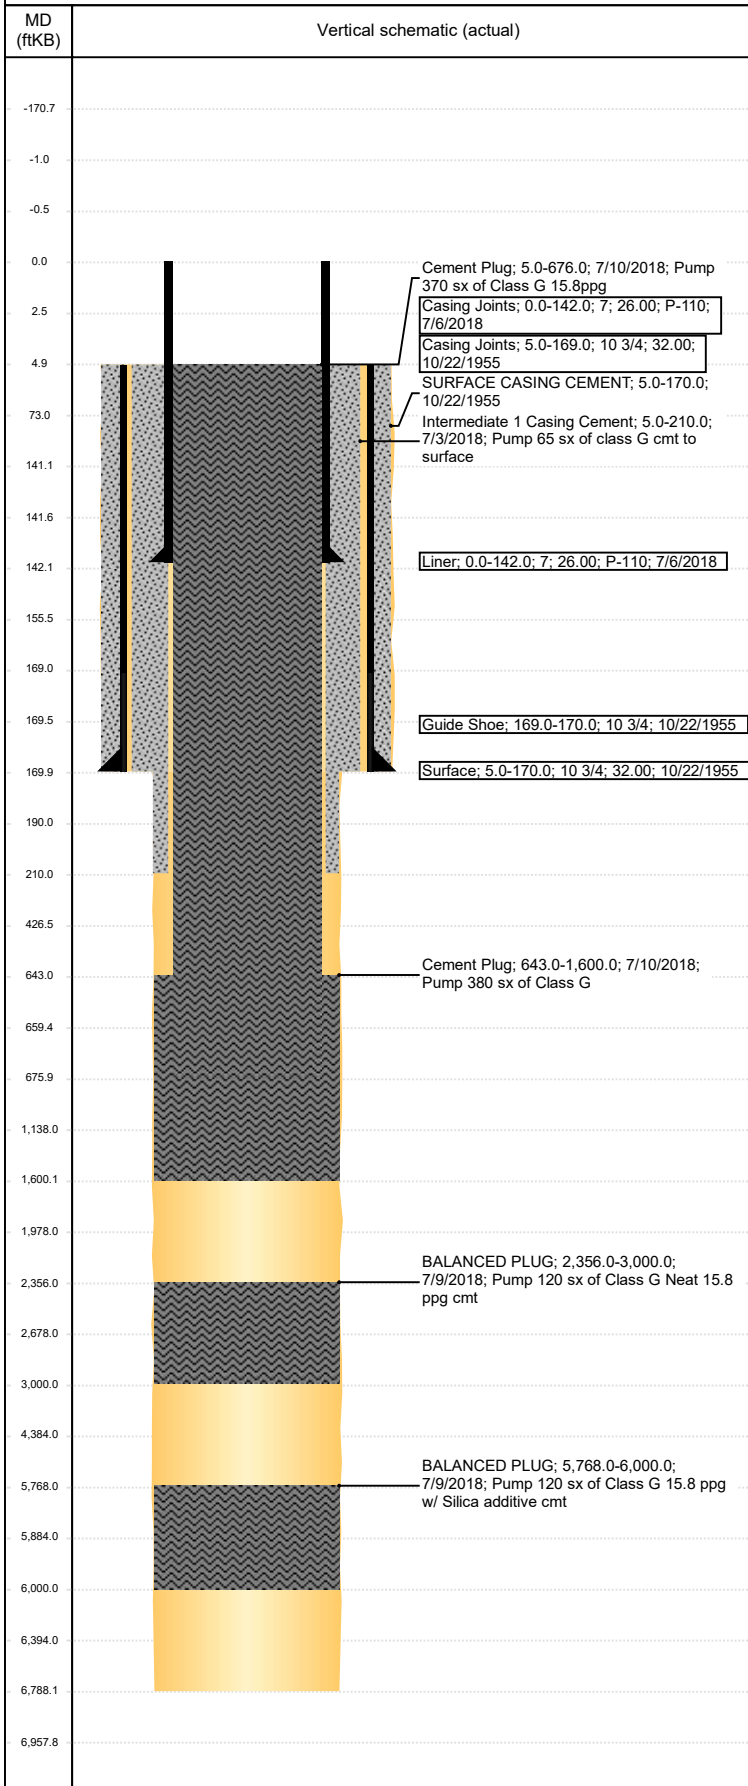

Well Header								
API 05-123-05556	Business Unit DJ BASIN		District 15		Well Config VERTICAL			
Original KB Elevation (ft)	KB - GL / MSL (ftKB)		Spud Date 10/22/1955		P & A Date 7/10/2018			
Comment NO RECORDS OR INFO ON P&A OF WELL. ASSUMED 10 SX SURFACE PLUG ON TOP. GL ELEV AVAILABLE BUT NOT KB ELEV. ASSUMED KB OF 5 FT BASED ON OTHER DA WELLS.								
Directions To Well HWY 14 & 115, NORTH ON 115 2.4 MILES WEST INTO LOCATION RIG SIGN ON LEFT								
Congressional Location								
Quarter 3 SW	Quarter 4 SW	Section 16	Township 8	Twnshp N/S Dir N	Range 59	Range E/W Dir W		
Bottom Hole Location								
North-South Distance (ft)		From N or S Line		East-West Distance (ft)		From E or W Line		
Plug Back Total Depths								
Date	Depth (ftKB)	Method			Com			
Wellbore Sections								
Section Des		Size (in)		Act Top, MD (ftKB)	Act Btm, MD (ftKB)			
SURFACE		12 1/4		5	170			
PRODUCTION		7 7/8		170	6,788			
Zone Statuses								
Zone Name	Status Date	Status	Fluid Type	Job	Prod Method			
Casing Strings								
Intermediate 1, 142.0ftKB								
Casing Description Intermediate 1	Run Date 7/3/2018	OD (in) 7	Wt/Len (l... 26.00	Grade C-75	Top, MD (ft... -1.0	MD (ftKB) 142.0		
Liner, 142.0ftKB								
Casing Description Liner	Run Date 7/6/2018	OD (in) 7	Wt/Len (l... 26.00	Grade P-110	Top, MD (ft... 0.0	MD (ftKB) 142.0		
Surface, 170.0ftKB								
Casing Description Surface	Run Date 10/22/1955	OD (in) 10 3/4	Wt/Len (l... 32.00	Grade	Top, MD (ft... 5.0	MD (ftKB) 170.0		
Cement								
Description SURFACE CASING CEMENT				Top Depth (ftKB) 5.0		Bottom Depth (ftKB) 170.0		
Description SHOE PLUG				Top Depth (ftKB) 0.0		Bottom Depth (ftKB) 0.0		
Description Intermediate 1 Casing Cement				Top Depth (ftKB) 5.0		Bottom Depth (ftKB) 210.0		
Description Cement Plug				Top Depth (ftKB) 5.0		Bottom Depth (ftKB) 210.0		
Description BALANCED PLUG				Top Depth (ftKB) 2,356.0		Bottom Depth (ftKB) 3,000.0		
Description BALANCED PLUG				Top Depth (ftKB) 5,768.0		Bottom Depth (ftKB) 6,000.0		
Description Cement Plug				Top Depth (ftKB) 643.0		Bottom Depth (ftKB) 1,600.0		
Description Cement Plug				Top Depth (ftKB) 5.0		Bottom Depth (ftKB) 676.0		
Tubing Strings								
Tubing Description		Run Date	String...	ID (in)	Wt (lb/ft)	Grade	Len (ft)	Set De...
Other In Hole								
Run Date		Des			OD (in)	Top (ftKB)	Btm (ftKB)	
Logs								
Date		Type				Top, MD (ftKB)	Btm, MD (ftKB)	