


# Topo Map

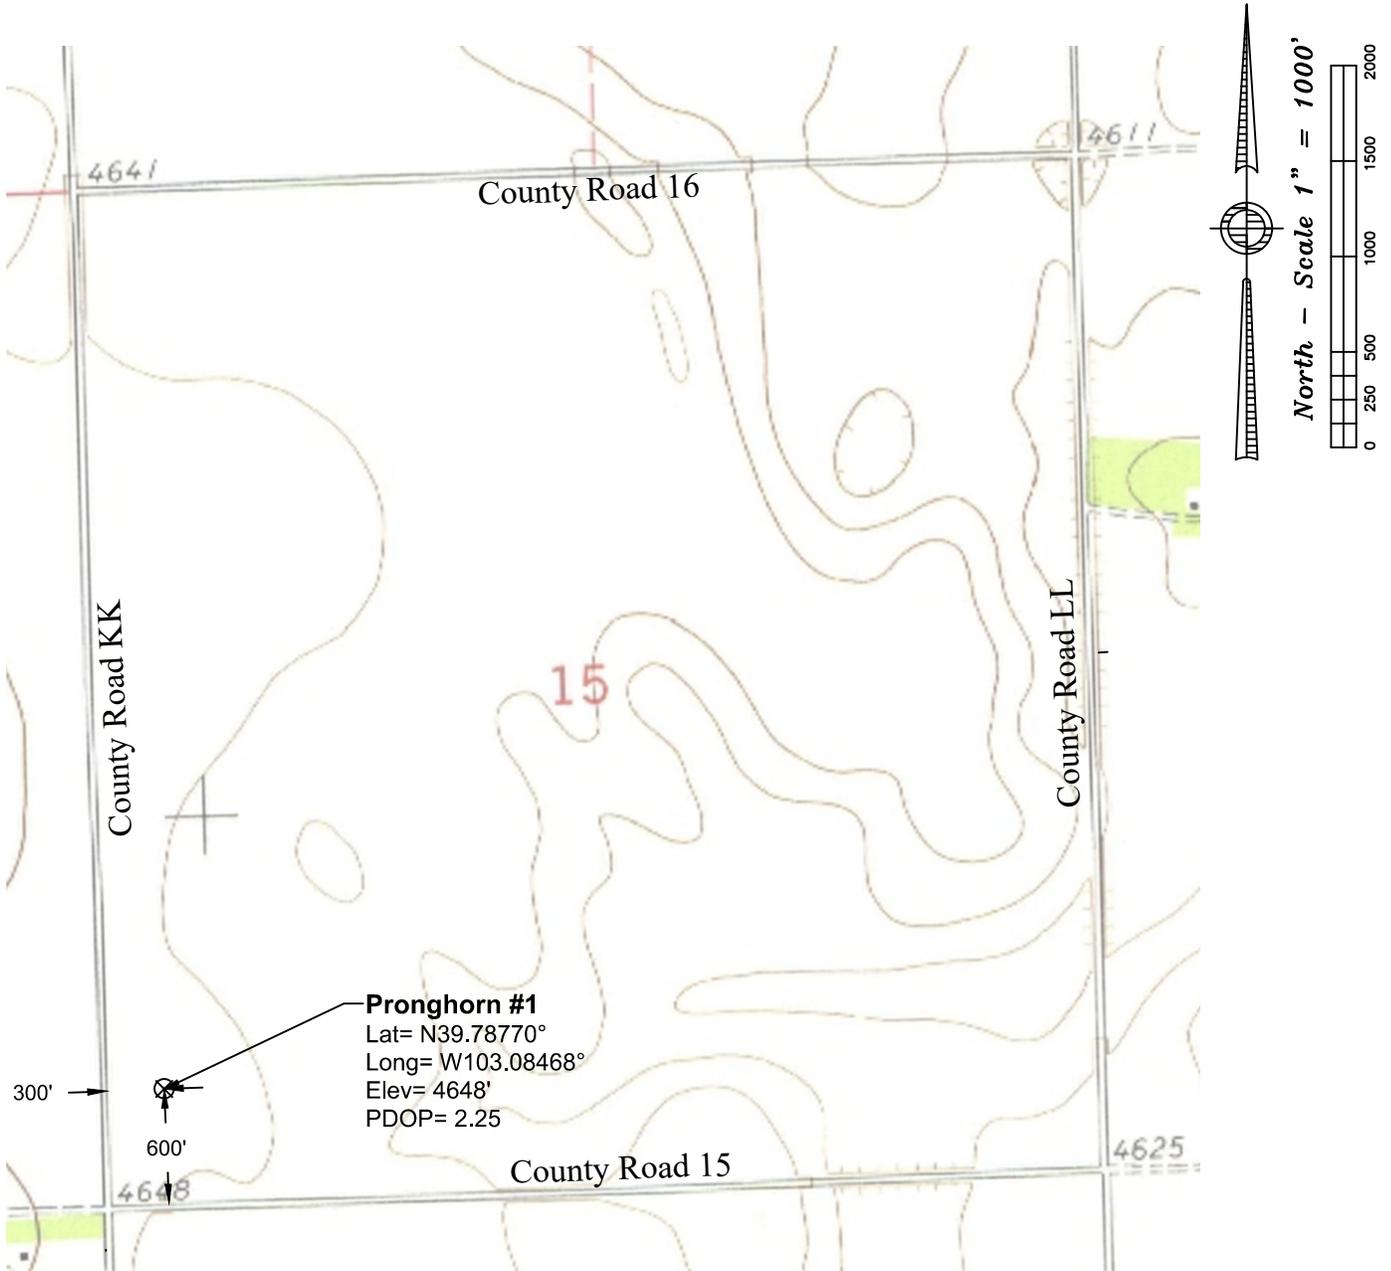

**Notes:**

- In accordance with a request from St. Croix Operating, Inc., PLS Group has determined the location of the Pronghorn #1 well to be 300' FWL and 600' FSL as measured perpendicular to the section lines.
- Survey elevations based on NAVD 88 Datum using GPS observed heights and Geoid 12B corrections.
- Distances shown are in SPC grid feet. Ground scale factor= 1.000229106650.
- There are no improvements within 100' of the proposed well site.
- Apparent Land Use is cropland.
- Vegetation is undetermined.
- Topographic map contours and spot elevations based on NGVD 1929 Datum.
- Topographic map dated 1978.

P:\Project\2018\18050\dwg\18050\_Topo.dwg June 19, 2018 - 9:36am

Well Name: <b>Pronghorn #1</b>	Field Date <b>6.1.2018</b>	Prepared for: <b>Project#: 18050.001</b>
Section 15-T3S-R51W-6th PM, SW-SW	Party Chief <b>ADS</b>	<b>St. Croix Operating, Inc.</b>  PLS Group 6843 North Franklin Avenue Loveland, Colorado 80538 970.669.2100 office - 970.669.3652 fax
Washington County, Colorado	Proj. Manager <b>ZNB</b>	
	Drawing Date <b>6.13.2018</b>	