




CERTIFICATE OF SURVEY  
for  
Sands-American  
Adams County, Colorado

RECEIVED

MAY 28 1974

COLORADO OIL & GAS CONS. COMM.

T1S R67W6PM

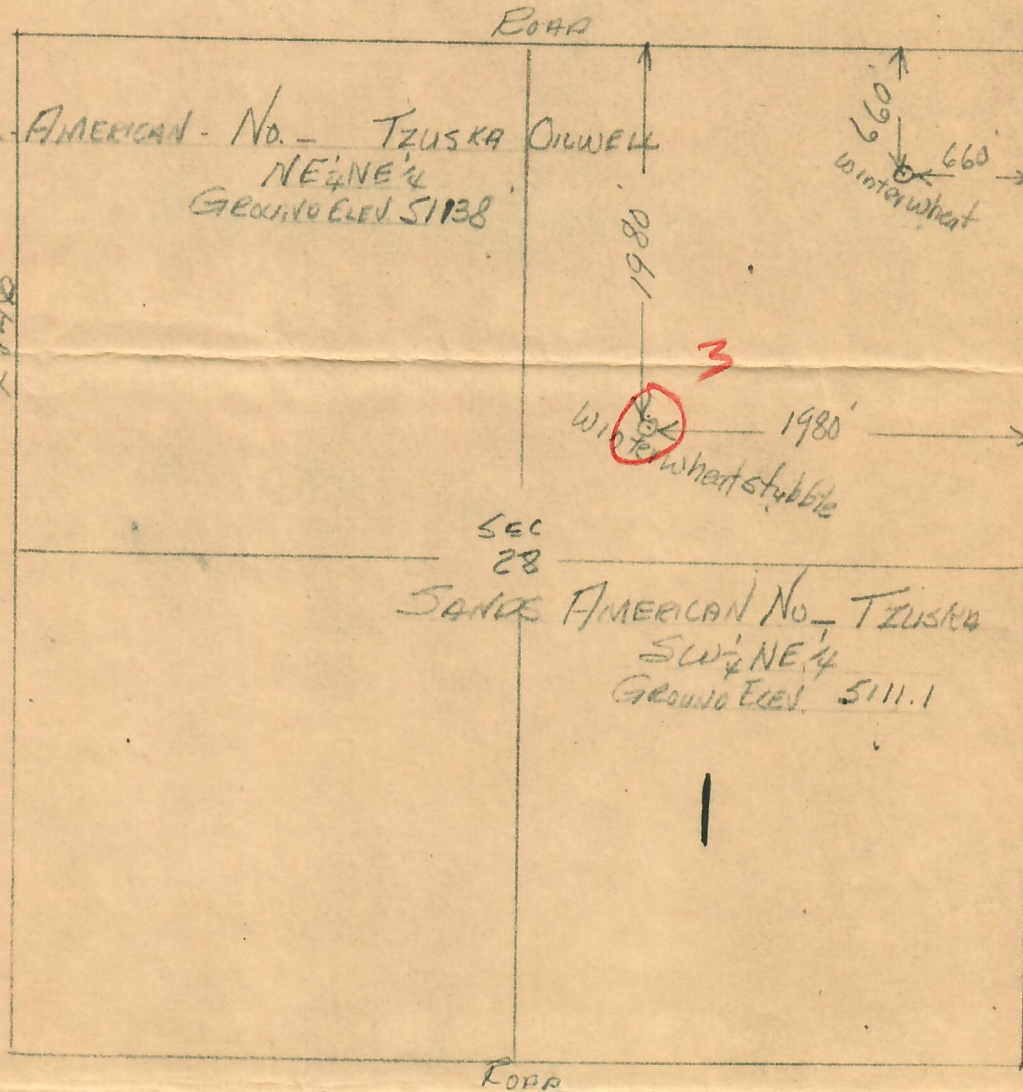

I hereby certify that the above plat is an accurate representation of a correct survey showing the location of Sands-American No. \_\_\_\_\_ Tzuska Oilwell in NE 1/4 NE 1/4 Sec. 28 T1S R67W 6PM. The elevation of the ground at the stake is 5113.8 feet above sea level. And Sands-American No. \_\_\_\_\_ Tzuska Oilwell in SW 1/4 NE 1/4 Sec. 28 T1S R67W 6PM. The elevation of the ground at the stake is 5111.1 feet above sea level from U.S.G.S. Bench Mark.

Fort Morgan, Colorado  
Nov. 18, 1973

*Leahy Osborne*  
Registered Professional Engineer  
State of Colorado