



Lat40°, Inc. 6250 W. 10th Street, Unit 2, Greeley, CO 970-515-5294


# WELL LOCATION CERTIFICATE

WELLS RANCH AE29-669

SECTION: 29  
TOWNSHIP: 6N  
RANGE: 62W  
6TH. P.M.  
WELD COUNTY, CO

Approved by  
Cory Miller  
08/27/2018

Estimated TPZ: 1410' FNL, 325'  
FEL 30-T6N-R62W, NBL Hand  
Drawn 8/2018

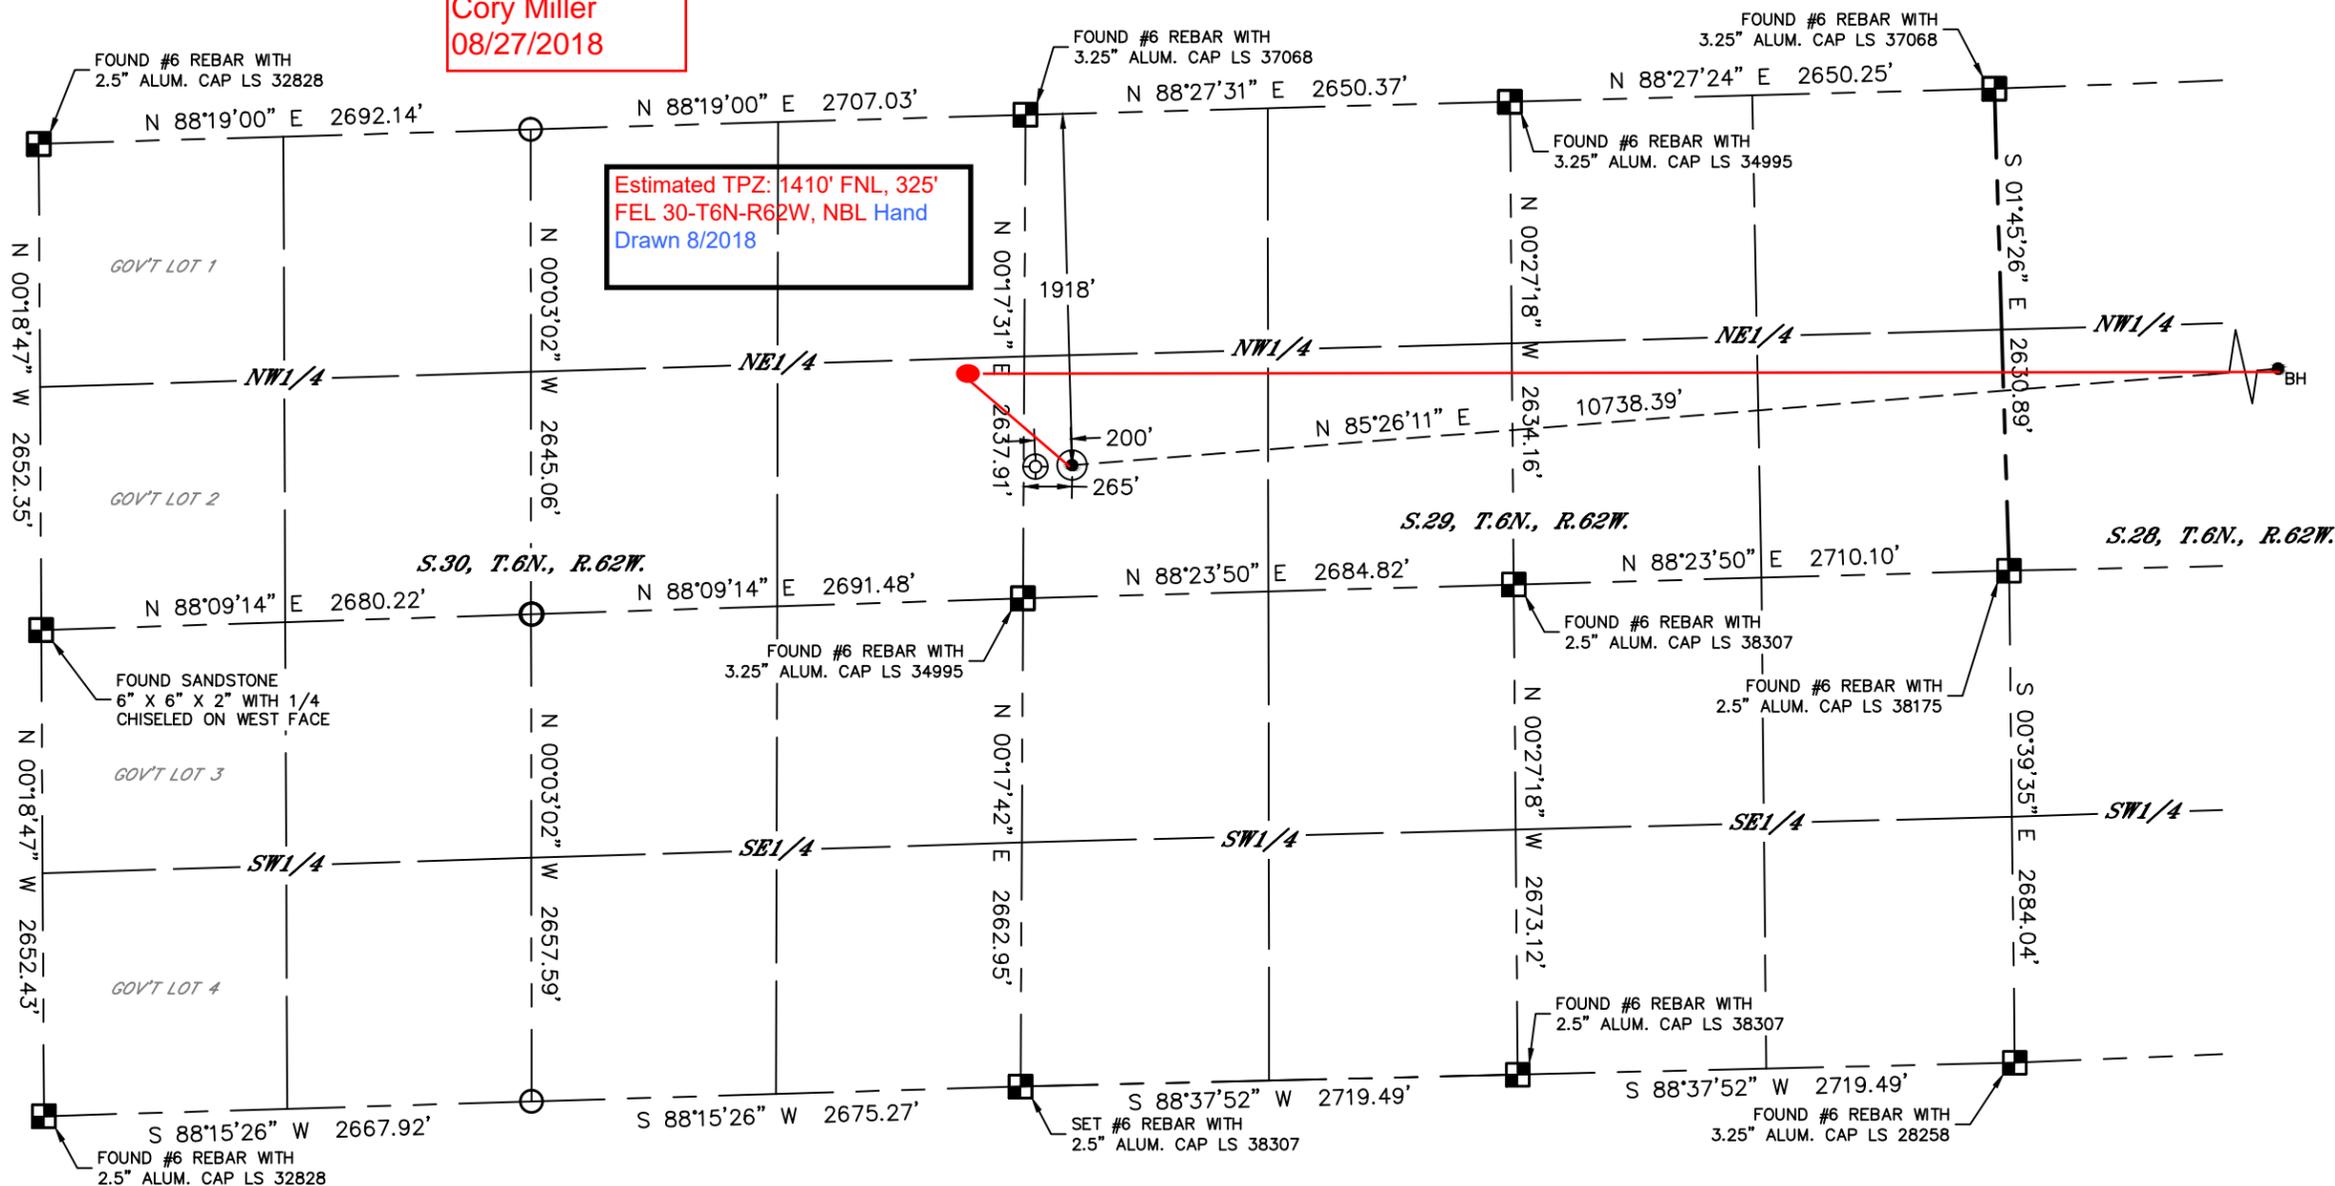



CLIENT: NOBLE ENERGY, INC.				LANDMAN: GREG WILSON					
INSTRUMENT OPERATOR: JAKE STILLE				SURVEY DATE: 8/25/2017		SURFACE USE: RANGE LAND			
SHL FOOTAGE	SHL LAT°	SHL LONG°	SHL PDOP	SHL ELEV (FT.)	SHL 1/4/1/4	SHL S-T-R			
1918	FNL	265	FWL	40.45970	-104.35536	1.8	4768	SWNW	29-6-62

BHL FOOTAGE	BHL LAT°	BHL LONG°	BHL S-T-R			
1400	FNL	365	FWL	40.46166	-104.31686	27-6-62

NEAREST EXISTING WELL IN SHL 1/4/1/4	
EXISTING WELLS RANCH AE30-67-1AHNC	±200' W
NEAREST CULTURAL ITEMS	
BUILDING	5280'+
BUILDING UNIT	5280'+
HIGH OCCUPANCY BUILDING UNIT	5280'+
DESIGNATED OUTSIDE ACTIVITY AREA	5280'+
PUBLIC ROAD	5280'+
ABOVE GROUND UTILITY	5280'+
RAILROAD	5280'+
PROPERTY LINE	±265' W

NOTE:  
 1) Bearings shown are Grid Bearings of the Colorado State Plane Coordinate System, North Zone, North American Datum 1983. The lineal dimensions as contained herein are based upon the "U.S. Survey Foot."  
 2) Distances to section lines measured at 90 degrees from said section lines.  
 3) Ground elevations are based on an observed GPS elevation (NAVD 1988 DATUM).  
 4) Latitude and Longitude shown are (NAD 83 DATUM).  
 5) IMPROVEMENTS: See LOCATION DRAWING for all visible improvements within 500' of oil and gas location.  
 6) This map does not represent a boundary survey.

- LEGEND
- = ALIQUOT MONUMENT AS DESCRIBED
  - = CALCULATED POSITION
  - ⊙ = SURFACE HOLE LOCATION (SHL)
  - ▲ = ENTRY POINT LOCATION (EP)
  - = BOTTOM HOLE LOCATION (BHL)
  - ⊕ = EXISTING WELL
  - ⊖ = ABANDONED WELL

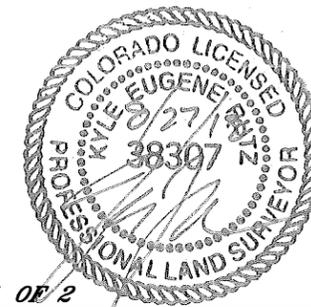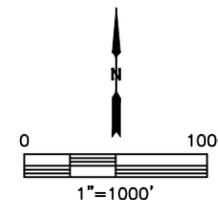

SHEET 1 OF 2  
 Kyle E. Rutz—On behalf of Lat40°, Inc.  
 Colorado Licensed Professional Land Surveyor No. 38307  
 DATE: 8/27/2018  
 PROJECT#: 2017064




Lat40°, Inc. 6250 W. 10th Street, Unit 2, Greeley, CO 970-515-5294

# WELL LOCATION CERTIFICATE

WELLS RANCH AE29-669

SECTION: 29  
TOWNSHIP: 6N  
RANGE: 62W  
6TH. P.M.  
WELD COUNTY, CO


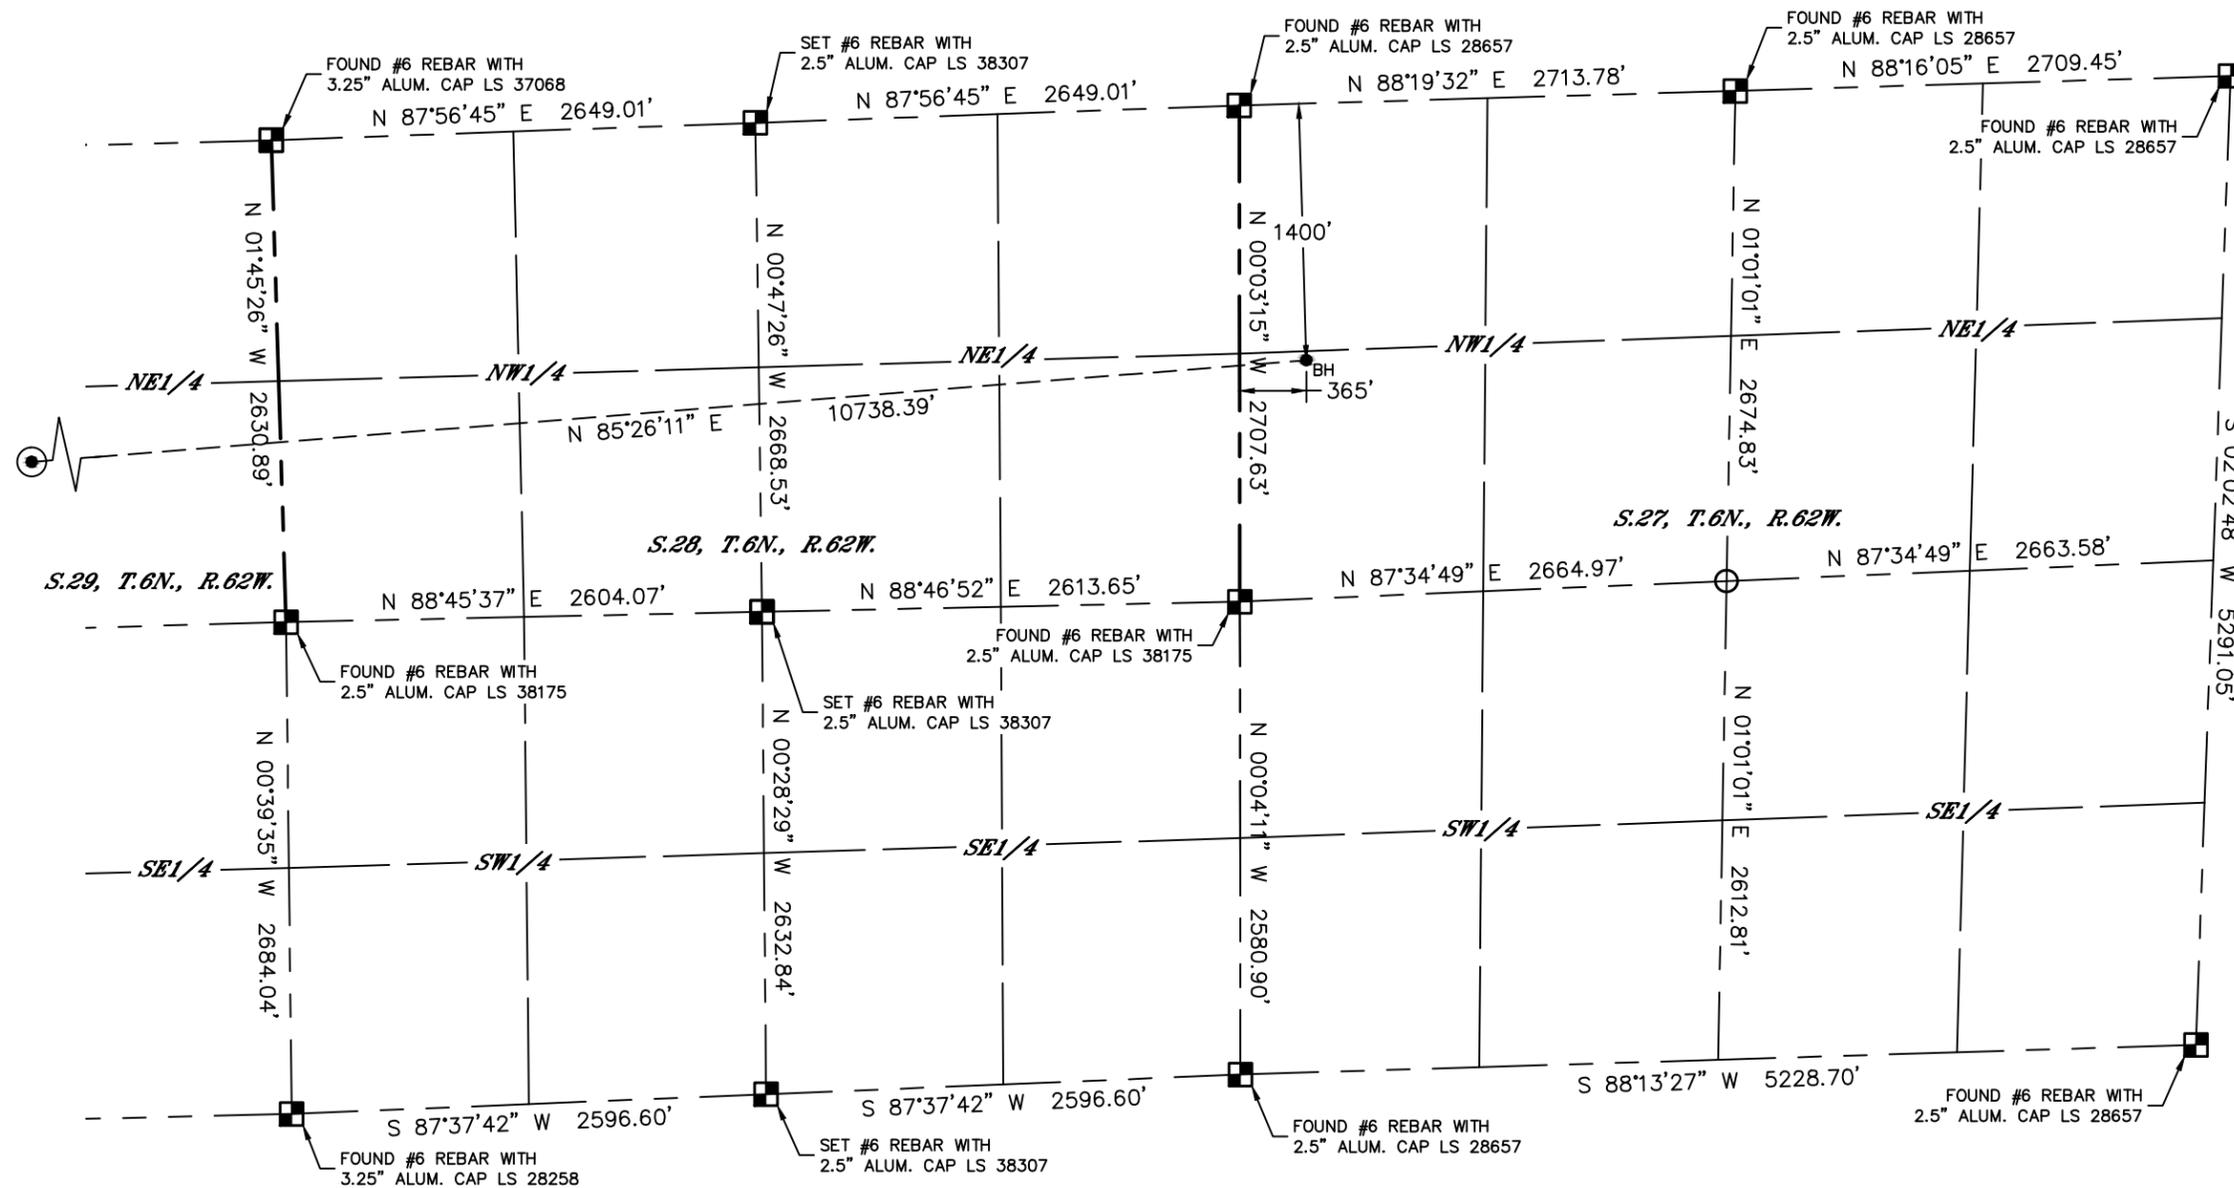


### NOTE:

- 1) Bearings shown are Grid Bearings of the Colorado State Plane Coordinate System, North Zone, North American Datum 1983. The lineal dimensions as contained herein are based upon the "U.S. Survey Foot."
- 2) Distances to section lines measured at 90 degrees from said section lines.
- 3) Ground elevations are based on an observed GPS elevation (NAVD 1988 DATUM).
- 4) Latitude and Longitude shown are (NAD 83 DATUM).
- 5) IMPROVEMENTS: See LOCATION DRAWING for all visible improvements within 500' of oil and gas location.
- 6) This map does not represent a boundary survey.

### LEGEND

- = ALIQUOT MONUMENT AS DESCRIBED
- = CALCULATED POSITION
- ⊙ = SURFACE HOLE LOCATION (SHL)
- ▲ = ENTRY POINT LOCATION (EP)
- = BOTTOM HOLE LOCATION (BHL)
- ⊕ = EXISTING WELL
- ⊖ = ABANDONED WELL

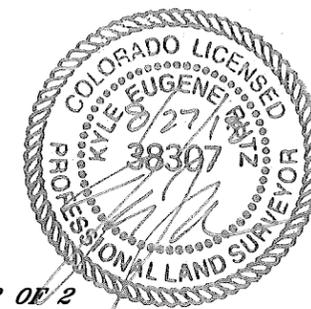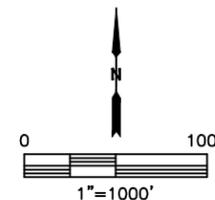

**SHEET 2 OF 2**

Kyle E. Rutz—On behalf of Lat40°, Inc.  
 Colorado Licensed Professional Land Surveyor No. 38307  
 DATE: 8/27/2018  
 PROJECT#: 2017064