

OIL AND GAS CONSERVATION COMMISSION OF THE STATE OF COLORADO

RECEIVED FEB 28 1958 OIL & GAS CONSERVATION COMMISSION



NOTICE OF INTENTION TO DRILL


INSTRUCTIONS:

A notice of intention to drill a well shall be filed in duplicate on all Federal and Patented lands, and in triplicate on all State lands. Do not begin operations until approved copy has been received. It is mandatory that the proposed location comply with all rules and regulations of the Commission. Locate well on section grid in proper location, and indicate extent of lease. Unless operations are commenced within 180 days after the date of approval hereof, this approval to drill will become null and void.

Name of Operator CHEROKEE AIR DRILLING, INC. Phone No. LU 4-7283
Address 3021 Sand Springs Road City TULSA State OKLAHOMA

How is liability secured: Well Bond (Attached) ; Blanket Bond ; Waiver
(Check one)

Lease Name TAYLOR
Well No. B-3
Field Name _____ Wildcat
County LA PLATA

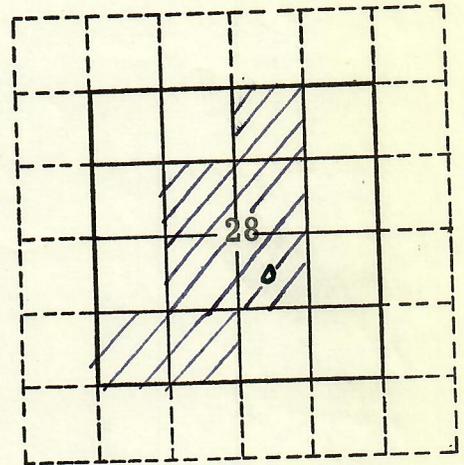

Location NW SE (quarter quarter) Section 28 Township 33N Range 12 W Meridian N. Mex

3222 feet from N Section line and 2022 feet from E Section Line
N or S E or W

The well is located on: Patented land State land Federal land

The well is located within a spaced area: Yes No

Distance from proposed location to nearest property or lease line 702 feet.
Distance from proposed location to nearest drilling unit line _____ feet.

Objectives: Mesa Verde Formation Depth 800 Estimate; _____ Formation Depth _____ Estimate

Proposed length of surface casing 80 feet.

REMARKS:

*This well is not approved
Spudded prior to approval.
OK*

Agen.	
Bond	
Spot	
600 ft.	
1200 ft.	
Wells	
Oil	
Gas	
Status	

I/We hereby swear (or affirm) that the statements herein made are a full and correct report.

APPROVED:

Company CHEROKEE AIR DRILLING, INC. Date Feb. 18, 1958

Date _____

Address 3021 Sand Springs Road Phone No. LU 4-7283

By Robert Taylor Title Vice-President
Signature

Director

See letter in Bond file.