


Schematic - Proposed vs Current Copy 1

Well Name: Norton A J 4

API/UWI 05-123-11763	Surface Legal Location	Field Name	License #	State/Province	Well Configuration Type
Original KB Elevation (ft)	Ground Elevation (ft)	Spud Date	Rig Release Date	PBTD (All)	Total Depth All (TVD)
Directions To Well					

Original Hole, 9/12/2018 12:31:05 PM

Vertical schematic (proposed)

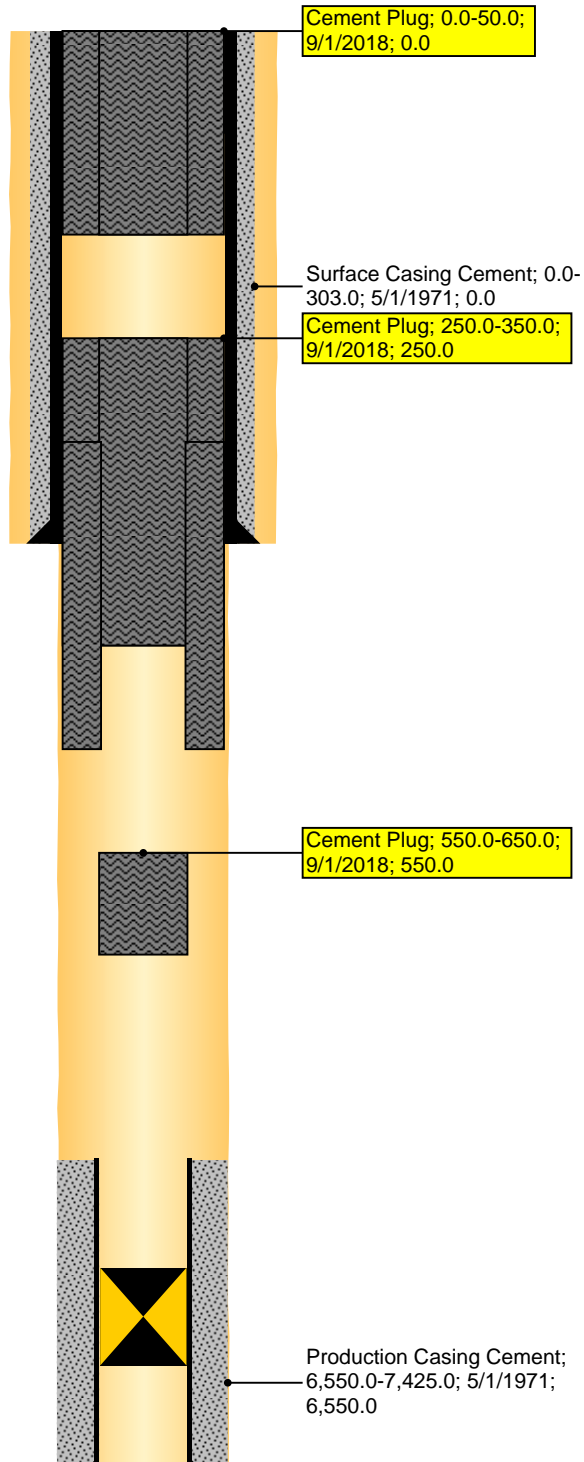

Vertical schematic (actual)

