


# GRAND MESA OPERATING COMPANY

Yosemite #1-3  
1007' FSL and 791' FEL  
Section 03 - T08S - R55W

Lincoln County, Colorado  
API # 05-073-06733-00  
Lat: 39.37716  
Long: -103.53142

Updated: September 4, 2018  
9:58 AM  
Prepared by: Lanny Butner

Spud: 08/05/2018 Date TD: 08/19/2018

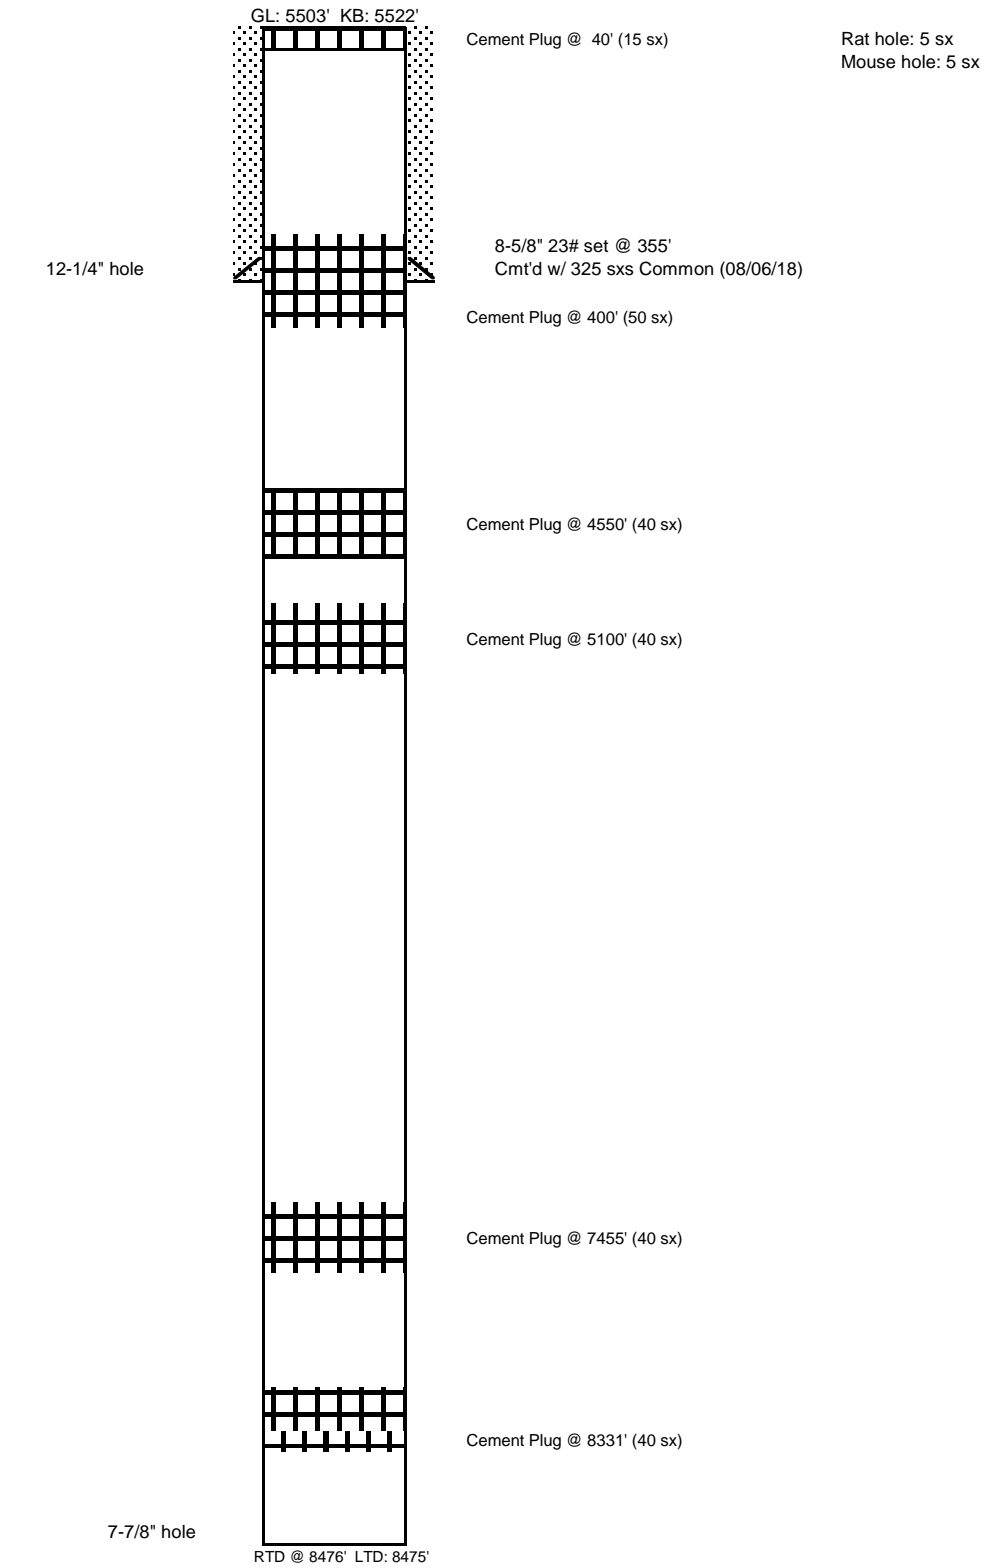

<u>Log Tops:</u>	
Bs Stone Corral	6135'
Marmaton	7507'
Atoka	7806'
Morrow	8042'
Mississippi	8379'