

Eyestone 7-34

Rosewood Resources, Inc.


PA - Form 6 Intent to Abandon

PLUGS SET

API 05-125-08689-00

SENE/4, Sect 34 –T4N-R47W, 6th Mer

Buffalo Grass Field

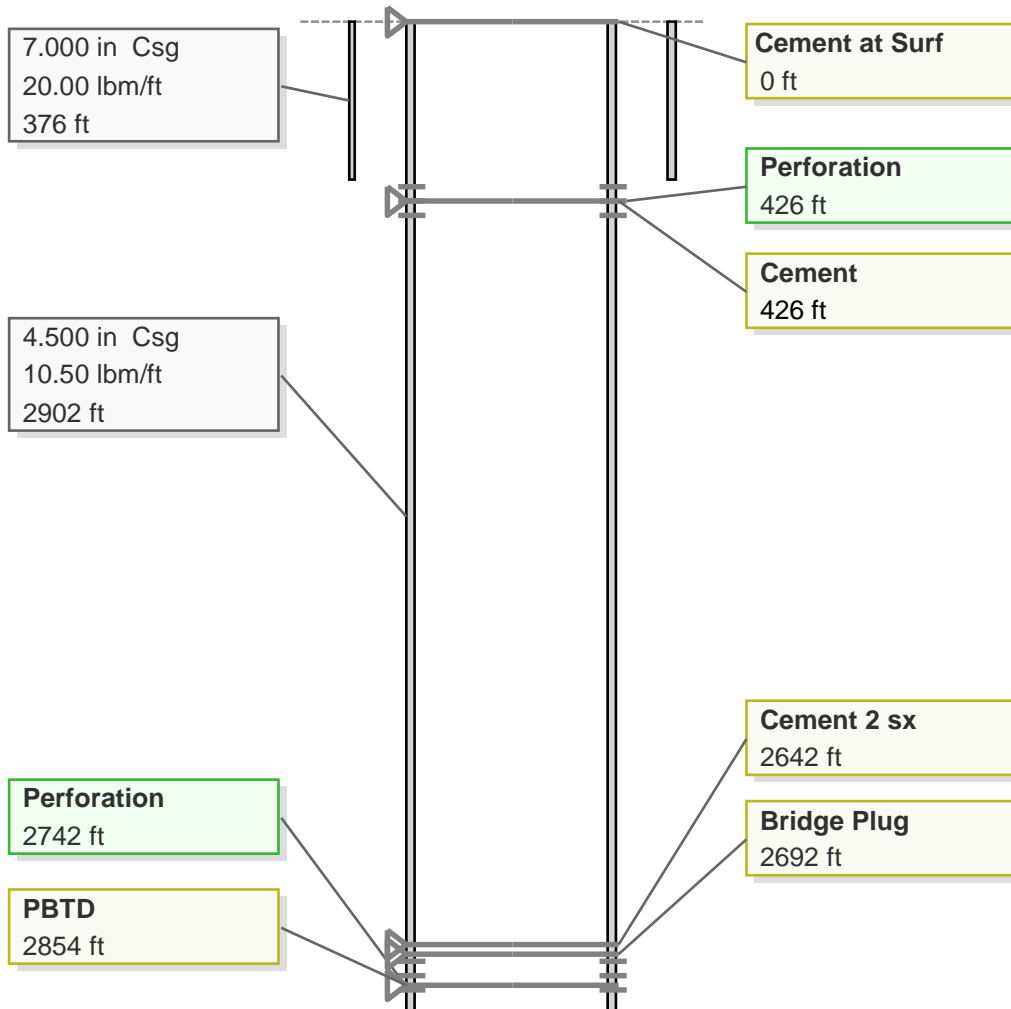

i-Handbook*

- *a mark of Schlumberger