



00816864

RECEIVED

FEB 10 1968


COLO. OIL & GAS CONS. COMM.

R. 53W

N



T. 8N

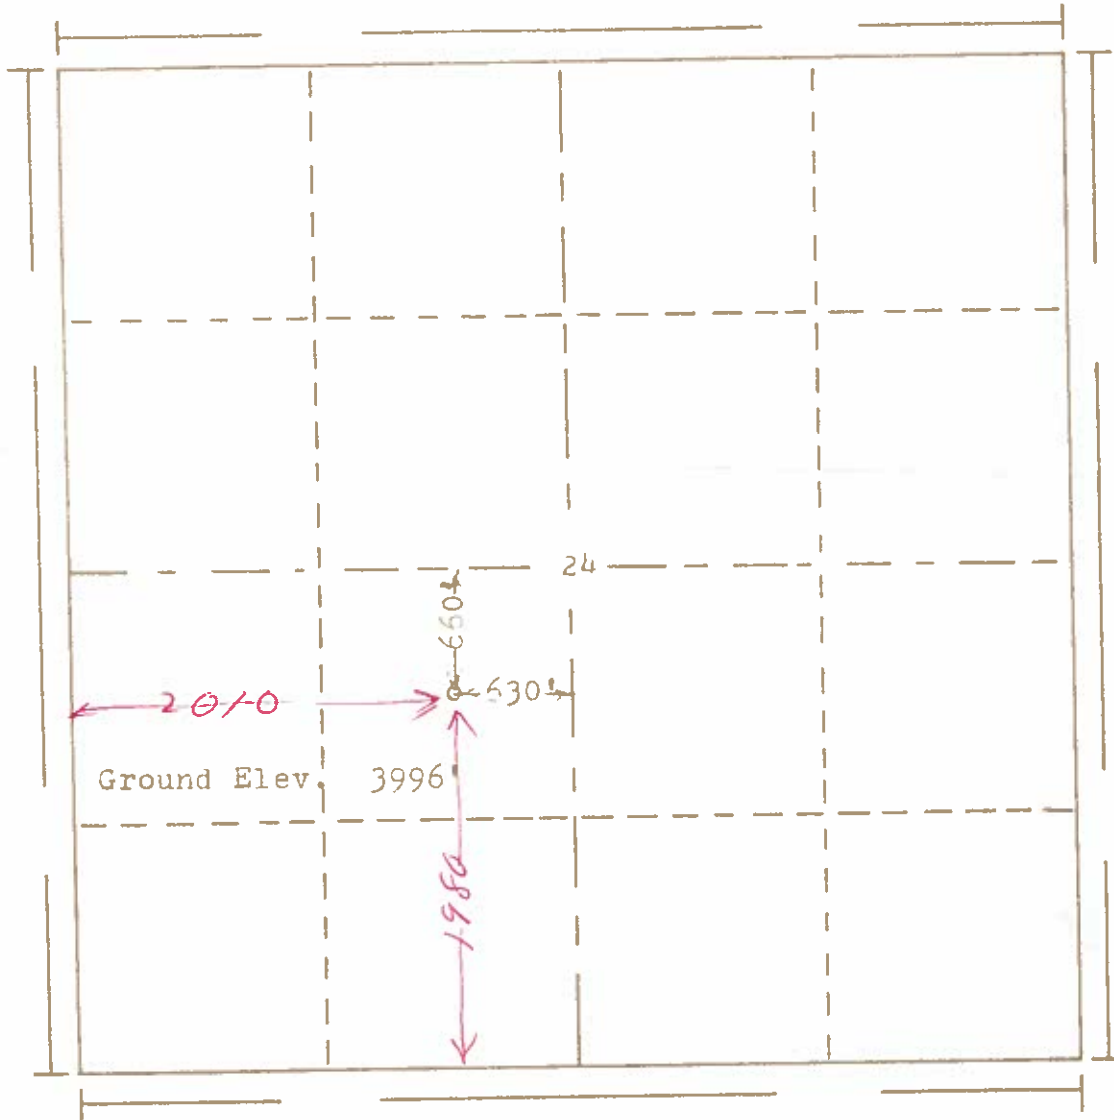

Scale... 1" = 1000'

Powers Elevation Company, Inc. of Denver, Colorado
has in accordance with a request from Mr. Bander
for Bander & Couch

determined the location of No. 2 Wilson
to be CNE SW Section 24 Township 8N
Range 53W of the 6th Principal Meridian
Logan County, Colorado

I hereby certify that this plat is an
accurate representation of a correct
survey showing the location of

Date 1-2-65

Eric G. Helmer
Licensed Land Surveyor No. 2853
State of Colorado

68-3