

RECEIVED

RECEIVED


APR 14 1989

COLO. OIL & GAS CONS. COM.

CERTIFICATE OF SURVEY  
for  
Patrick A. Doheny  
Washington County, Colorado



T2N R53W 6PM

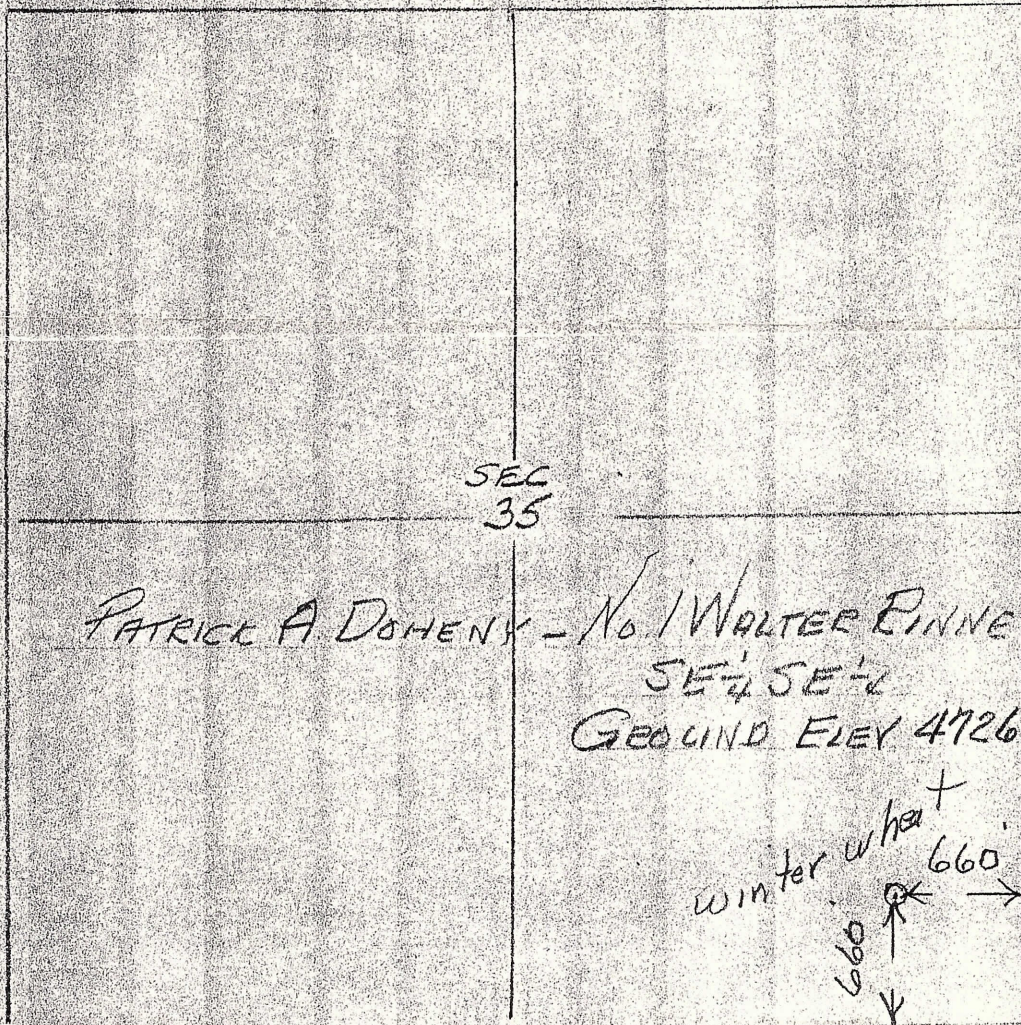

I hereby certify that the above plat is an accurate representation of a correct survey showing the location of Patrick A. Doheny-No. 1 Walter Rinne Oilwell in SE 1/4 Sec. 35 T2N R53W 6PM. The elevation of the ground at the stake is 4726.0 feet above sea level from U.S.G.S. Bench Mark.

Fort Morgan, Colorado  
March 31, 1989

*Lucy A. ...*  
Registered Professional Engineer  
State of Colorado