



00054878


CERTIFICATE OF SURVEY
for
Okmar Oil Co.
Morgan County, Colorado

RECEIVED

OCT 30 1973

COLORADO OIL & GAS CONS. COM. 1

T2N R56W 6PM

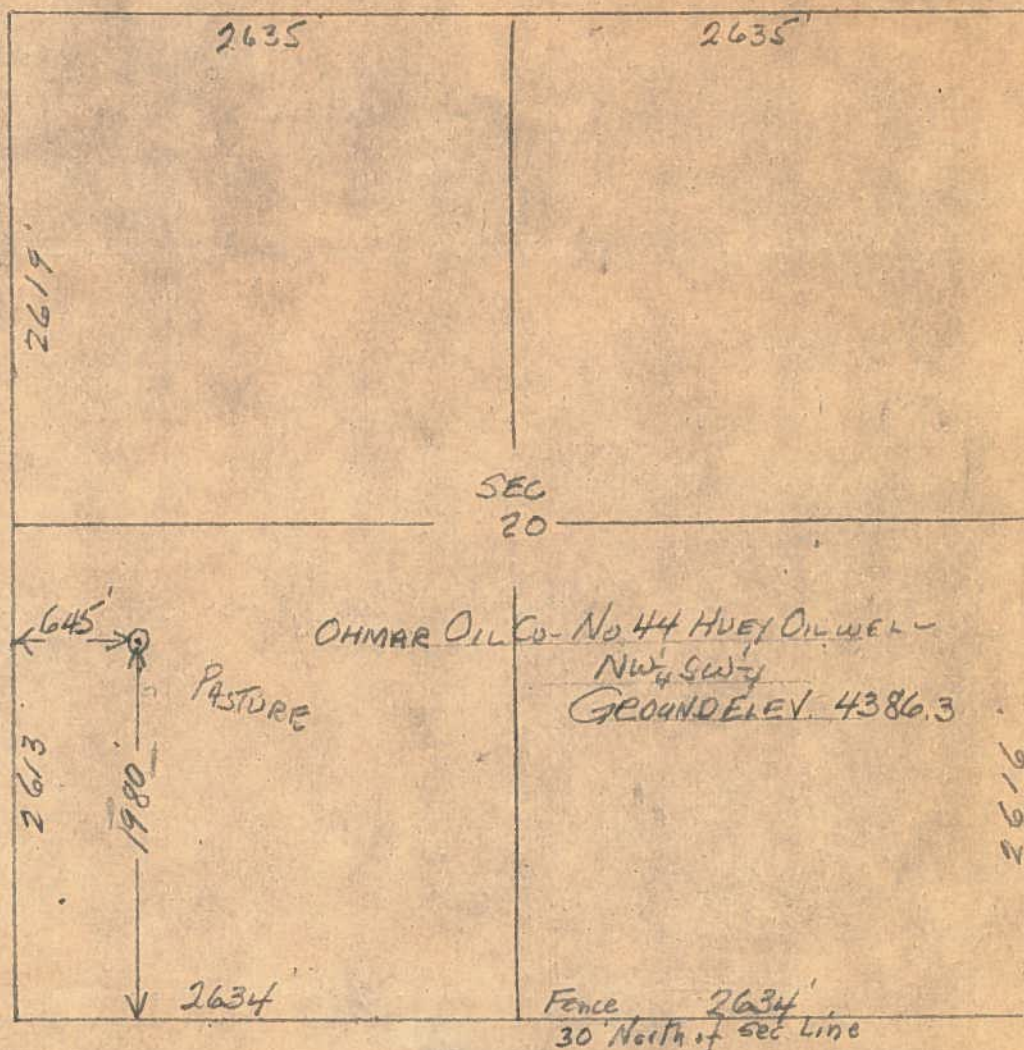

I hereby certify that the above plat is an accurate representation of a correct survey showing the location of Okmar Oil Co., No. 44 Huey Oilwell in NW 1/4 SW 1/4 Sec. 20 T2N R56W 6PM. The elevation of the ground at the stake is 4386.3 feet above sea level from U.S.C.S. Bench Mark.

Fort Morgan, Colorado
Oct .11, 1973

Leslie J. Osborne
Registered Professional Engineer
State of Colorado

13-799