



# Kerr-McGee Oil & Gas Onshore LP

A subsidiary of Anadarko Petroleum Corporation

501 North Division Blvd.  
Platteville, CO 80651  
970-336-3500

September 20, 2018

Shultz Farm Inc.  
2775 Blue Acona Way  
Johnstown, CO 80534-4646

Re: **State 16-2 Well**  
Township 4 North, Range 67 West, 6<sup>th</sup> P.M  
Section 16: SESE  
Weld County, Colorado

Dear Mr. Shultz

The State 16-2 well located on your property that was plugged by an Operator in 2005, needs to be re-entered and re-plugged to ensure the integrity of the well bore. Prior to commencement of those operations, which we anticipate will commence within 30 – 60 days, the Colorado Oil and Gas Conservation Commission requires we inform you, and secure your agreement to the procedures.

Please acknowledge your receipt of this notice and your consent to the proposed operations by signing, dating, and returning this letter to the undersigned.

If you have any questions or concerns regarding this matter, please do not hesitate to contact me directly at (970) 515-1370.

Thank you,


KERR MCGEE OIL & GAS ONSHORE LP

Colleen Nealy  
Project Land Advisor

I understand that a well will be re-entered and re-plugged on my land and I consent to those operations.

By: Steven E. Shultz  
Steven E. Shultz, President

Date: 9-24-2018

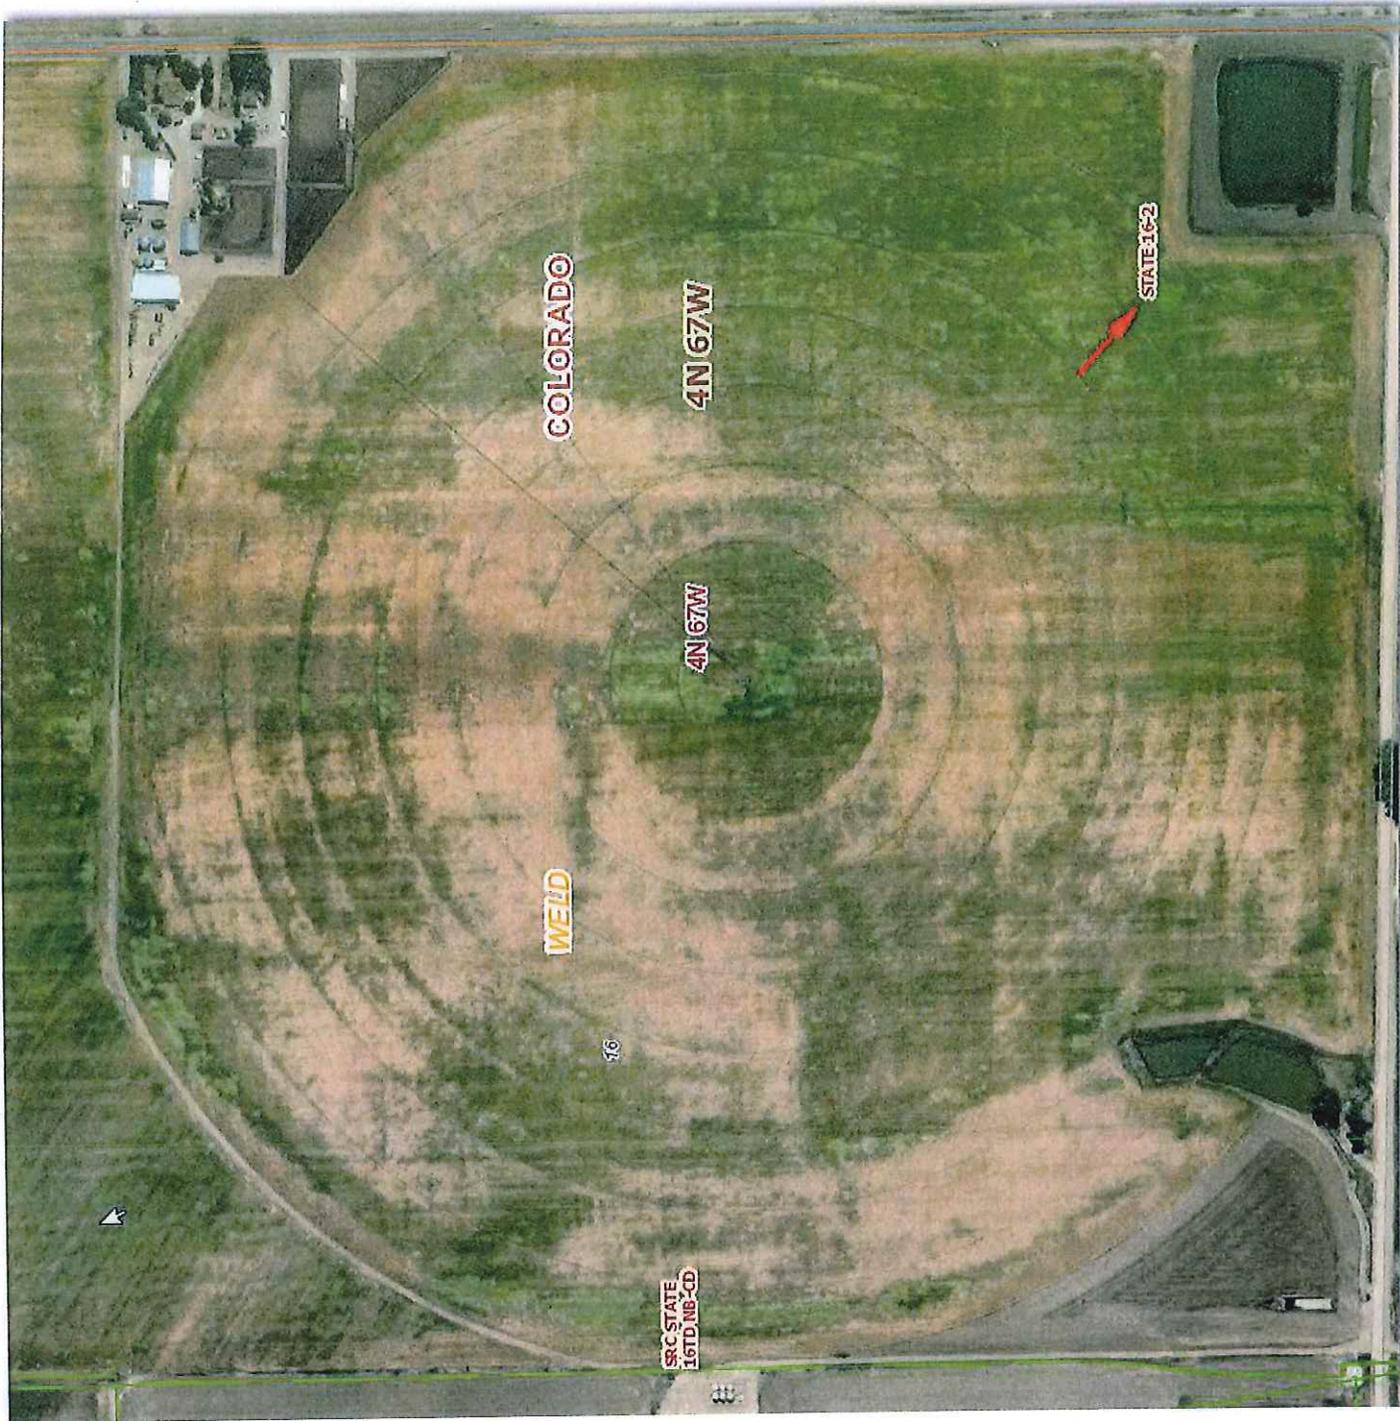

COLORADO

4N 67W

4N 67W

WELD

STATE 16-2

16

SRC STATE  
16TD 16B-CD

