




Downhole Well Profile

Well Name: NPR 12D-10

API/UWI 05045237710000	Surface Legal Location Sec 10 T5S R96W	Field Name NPR	License #	State/Province CO	Well Configuration Type
Original KB Elevation (ft) 6,733.00	KB-Tubing Head Distance (ft)	Spud Date 7/8/2018 04:30	Rig Release Date 7/19/2018 14:30	PBTD (All) (ftKB) Original Hole - 9,635.0	Total Depth All (TVD) (ftKB)

Type						
Des	Make	Model	WP (psi)	Service	WP Top (psi)	Bore Min (in)

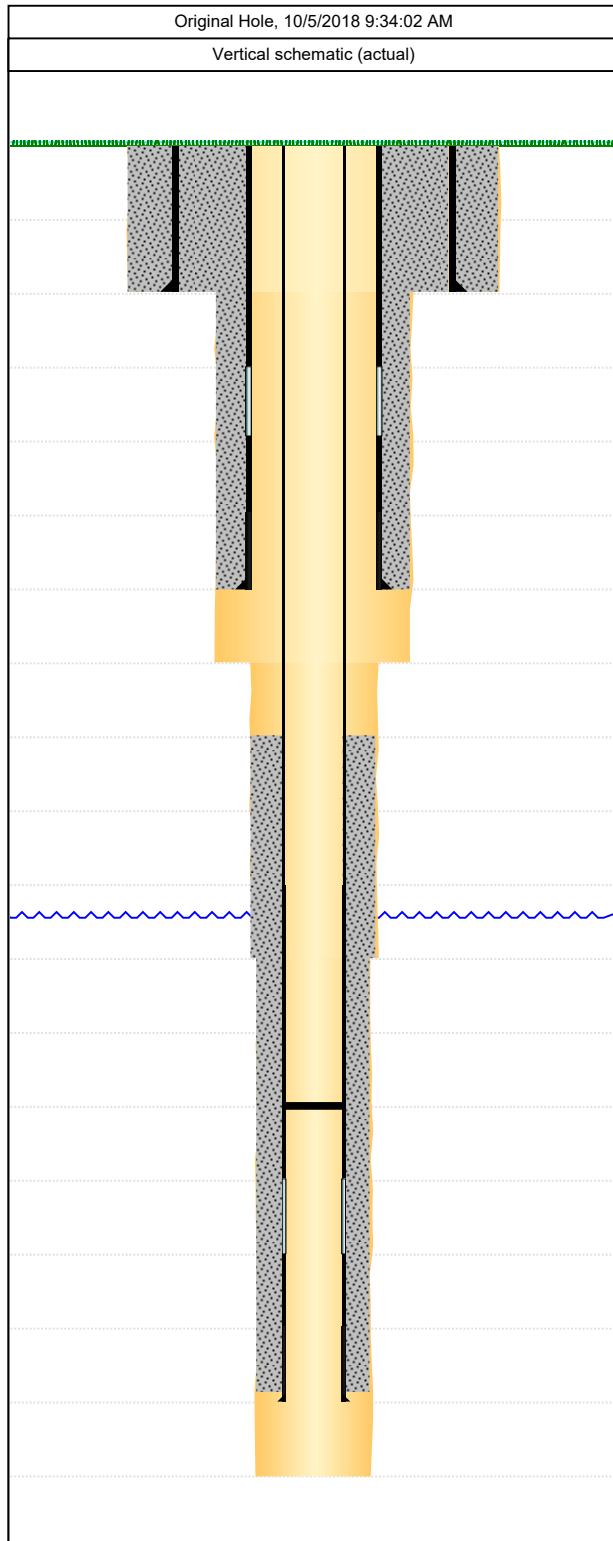

Casing Strings							
Csg Des	OD (in)	Wt/Len (lb/ft)	Grade	Top Thread	Set Depth (ftKB)		
Conductor	20	106.50	J55		120.0		
Surface	9 5/8	40.00	K-55	LT&C	2,385.0		
Production	4 1/2	11.60	P-110	LT&C	9,699.3		
Perforations							
Date	Top (ftKB)	Btm (ftKB)	Linked Zone				
Tubing Strings							
Tubing Description	Run Date		String Length (ft)	Set Depth (ftKB)			
Item Des	Jts	Make	Model	OD (in)	Wt (lb/ft)	Grade	Len (ft)
Rod Strings							
Rod Description	Run Date		String Length (ft)	Set Depth (ftKB)			
Item Des	Jts	Make	Model	OD (in)	Wt (lb/ft)	Grade	Len (ft)