


Well Name: KREYKES 13-14

VERTICAL - ORIGINAL HOLE, 10/4/2018 4:34:38 PM

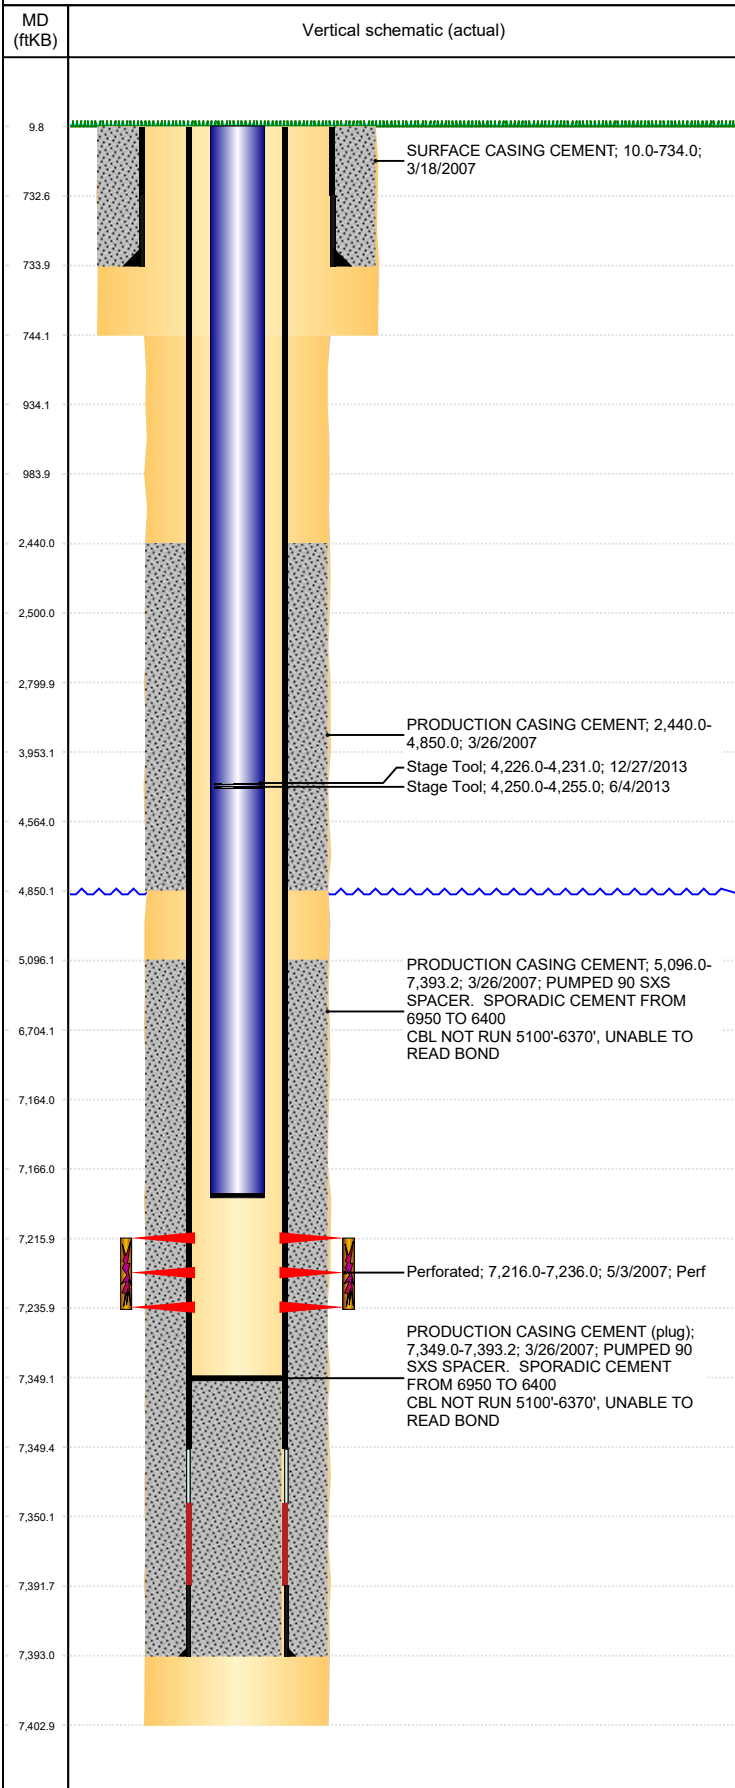

Well Header									
API 05-123-24764			Business Unit DJ BASIN			District 15		Well Config VERTICAL	
KB - GL / MSL (ft... 10.00		Spud Date 3/17/2007		P & A Date		Well Production Status SI			SoRT No
Comment									
Surface Location (Congressional)									
Qtr 3 SE	Qtr 4 NE	Section 13	Twnshp 6	Twnsh... N	Range 67	Rng E/... W	Actual Latitude (°) 40.48940000		Actual Longitude (°) -104.83408000
Wellbore Sections									
Section Des			Size (in)			Act Top, MD (ftKB)		Act Btm, MD (ftKB)	
SURFACE			12 1/4			10		744	
PRODUCTION			7 7/8			744		7,403	
Casing Strings									
Csg Des			Run Date		OD (in)	Wt/Len (lb/ft)	Grade	Top, MD (ftKB)	MD (ftKB)
Surface			3/18/2007		8 5/8	24.00		10.0	734.0
Production			3/26/2007		4 1/2	11.60	M-80	10.0	7,393.2
Cement									
Des					Start Date		Top (ftKB)		Btm (ftKB)
SURFACE CASING CEMENT					3/18/2007		10.0		734.0
PRODUCTION CASING CEMENT					3/26/2007		2,440.0		4,850.0
PRODUCTION CASING CEMENT					3/26/2007		5,096.0		7,393.2
Zone Statuses									
Zone Name		Status Date	Status	Fluid Type	Job			Prod Method	
CODELL		4/10/2010	PR	Water				Flowing	
CODELL		9/22/2016	SI						
Perforation Data									
Linked Zone			Bnch/Stg	Entered Shot Total	Top (ftKB)		Btm (ftKB)		Date
CODELL, ORIGINAL HOLE					7,216.00		7,236.00		5/3/2007
Stimulation Intervals									
Zone				Start Date		Top (ftKB)		Btm (ftKB)	
CODELL, ORIGINAL HOLE				5/5/2007		7,216.0		7,236.0	
Other In Hole									
Run Date		Des				OD (in)	Top (ftKB)	Btm (ftKB)	
Logs									
Date		Type				Top, MD (ftKB)		Btm, MD (ftKB)	
3/25/2007		COMPENSATED DENSITY				2,500.0		7,376.0	
3/25/2007		INDUCTION				733.0		7,396.0	
5/2/2007		CBL/CCL/GR				2,300.0		7,330.0	
7/2/2018		GYRO				10.0		7,100.0	
Plug Back Total Depths									
Date		Type		Com				Depth (ftKB)	
5/2/2007		FILL		DEPTH LOGGER ON CBL				7,332.0	
6/26/2007		FILL		CLEAN OUT TO LAND TUBING				7,349.0	