


Well Name: KREYKES 13-11

VERTICAL - ORIGINAL HOLE, 10/4/2018 4:31:02 PM

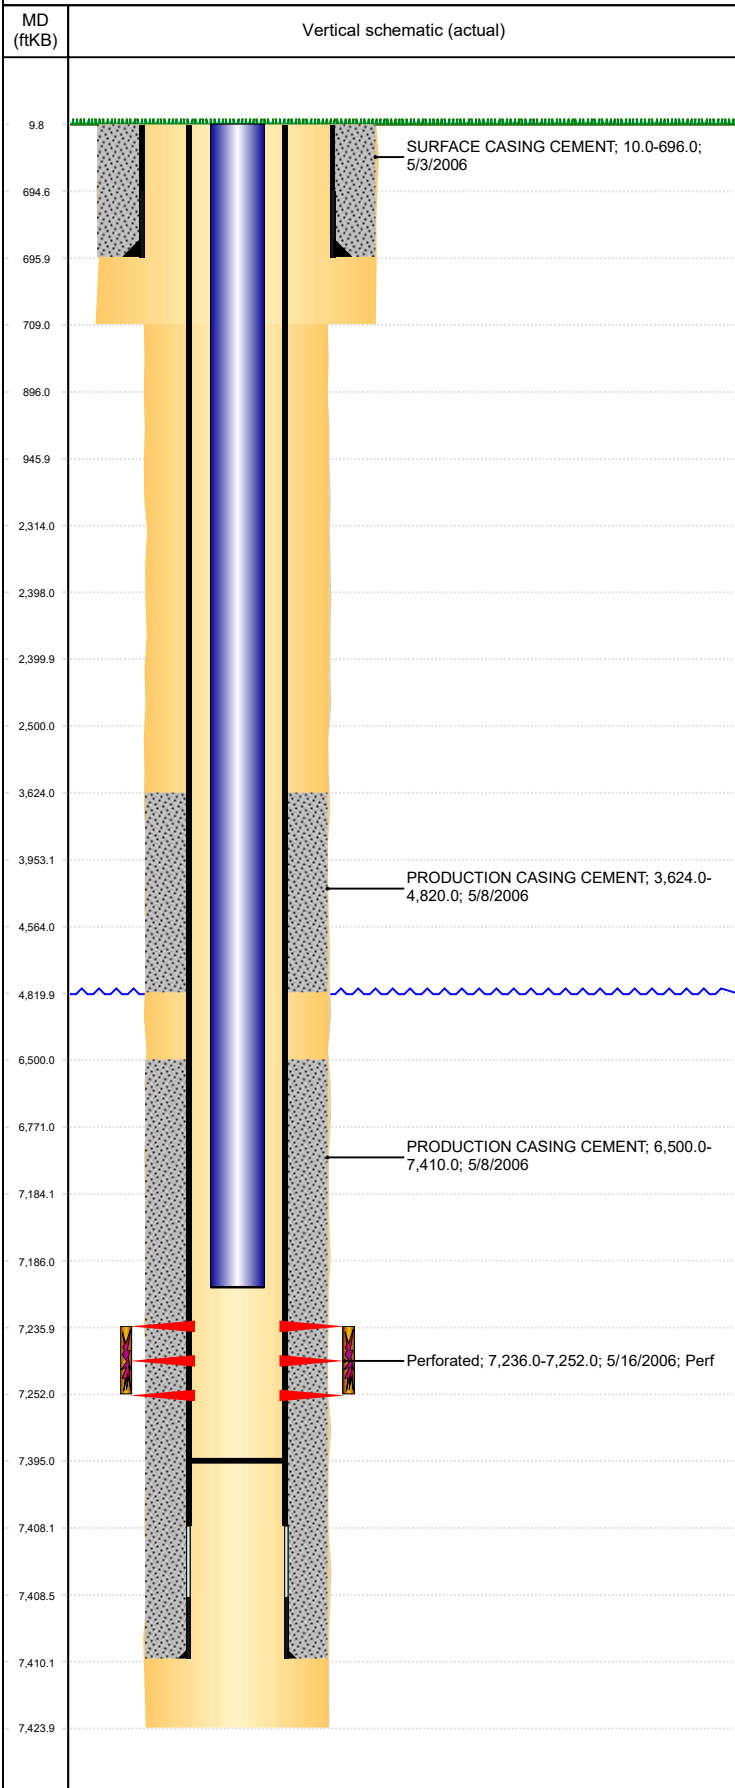

Well Header									
API 05-123-23683		Business Unit DJ BASIN			District 15		Well Config VERTICAL		
KB - GL / MSL (ft... 10.00		Spud Date 5/2/2006		P & A Date		Well Production Status SI			SoRT No
Comment DISCREP: NUMBER OF S CSG JOINT UNKNOWN; DRL RPT TD 7425, ST RPT TD 7424 USED ST RPT TD. FRAC DATA DISCREPANCY BETWEEN DRILLING REPORTS AND HALLIBURTON REPORT (USED DRILLING REPORT VALUES). HALLIBURTON REPORTS CDL REFRAC INFORMATION BUT THERE IS NO EVIDENCE IN THE FILE TO SUPPORT THIS.									
Surface Location (Congressional)									
Qtr 3 NE	Qtr 4 NE	Section 13	Twnshp 6	Twنش... N	Range 67	Rng E/... W	Actual Latitude (°) 40.49262000	Actual Longitude (°) -104.83446000	
Wellbore Sections									
Section Des			Size (in)			Act Top, MD (ftKB)		Act Btm, MD (ftKB)	
SURFACE			12 1/4			10		709	
PRODUCTION			7 7/8			709		7,424	
Casing Strings									
Csg Des			Run Date		OD (in)	Wt/Len (lb/ft)	Grade	Top, MD (ftKB)	MD (ftKB)
Surface			5/3/2006		8 5/8			10.0	696.0
Production			5/8/2006		4 1/2	11.60	M-80	10.0	7,410.0
Cement									
Des					Start Date		Top (ftKB)		Btm (ftKB)
SURFACE CASING CEMENT					5/3/2006		10.0		696.0
PRODUCTION CASING CEMENT					5/8/2006		3,624.0		4,820.0
PRODUCTION CASING CEMENT					5/8/2006		6,500.0		7,410.0
Zone Statuses									
Zone Name		Status Date		Status	Fluid Type	Job			Prod Method
CODELL		4/10/2010		PR	Water				Flowing
CODELL		9/22/2016		SI					
Perforation Data									
Linked Zone			Bnch/Stg	Entered Shot Total		Top (ftKB)		Btm (ftKB)	Date
CODELL, ORIGINAL HOLE				64		7,236.00		7,252.00	5/16/2006
Stimulation Intervals									
Zone					Start Date		Top (ftKB)		Btm (ftKB)
CODELL, ORIGINAL HOLE					5/17/2006		7,236.0		7,252.0
Other In Hole									
Run Date		Des				OD (in)	Top (ftKB)		Btm (ftKB)
Logs									
Date		Type					Top, MD (ftKB)		Btm, MD (ftKB)
5/8/2006		COMPENSATED DENSITY					3,000.0		7,398.0
5/8/2006		INDUCTION					704.0		7,418.0
5/16/2006		SONIC					3,450.0		7,382.0
9/14/2006		CBL/CCL/GR					4,100.0		5,100.0
9/14/2006		CEMENT BOND					4,100.0		5,100.0
7/2/2018		GYRO					10.0		7,100.0
Plug Back Total Depths									
Date		Type			Com				Depth (ftKB)
5/16/2006		FILL			DEPTH LOGGER ON CBL				7,384.0
7/28/2006		FILL			CLEANOUT				7,395.0