




**Current Wellbore Schematic**

Well Name: Strasser 1-27  
 Location: 660' FSL, 660' FEL, NENE Sec 27, T9N, R60W  
 County: Weld  
 API #: 05-123-07198  
 Co-ordinates: 40.726629 / -104.071124  
 Elevations: GROUND: 4984'  
KB: 12'  
 Depths (KB): PBTD: 6965'  
TD: 6995'

Date Prepared: 9/13/2018  
 Last Updated: 9/13/2018  
 Spud Date: 4/10/1979  
 Completion Start Date: 1986  
 Last Workover Date: N/A  
 Prepared by: Elizabeth Kane

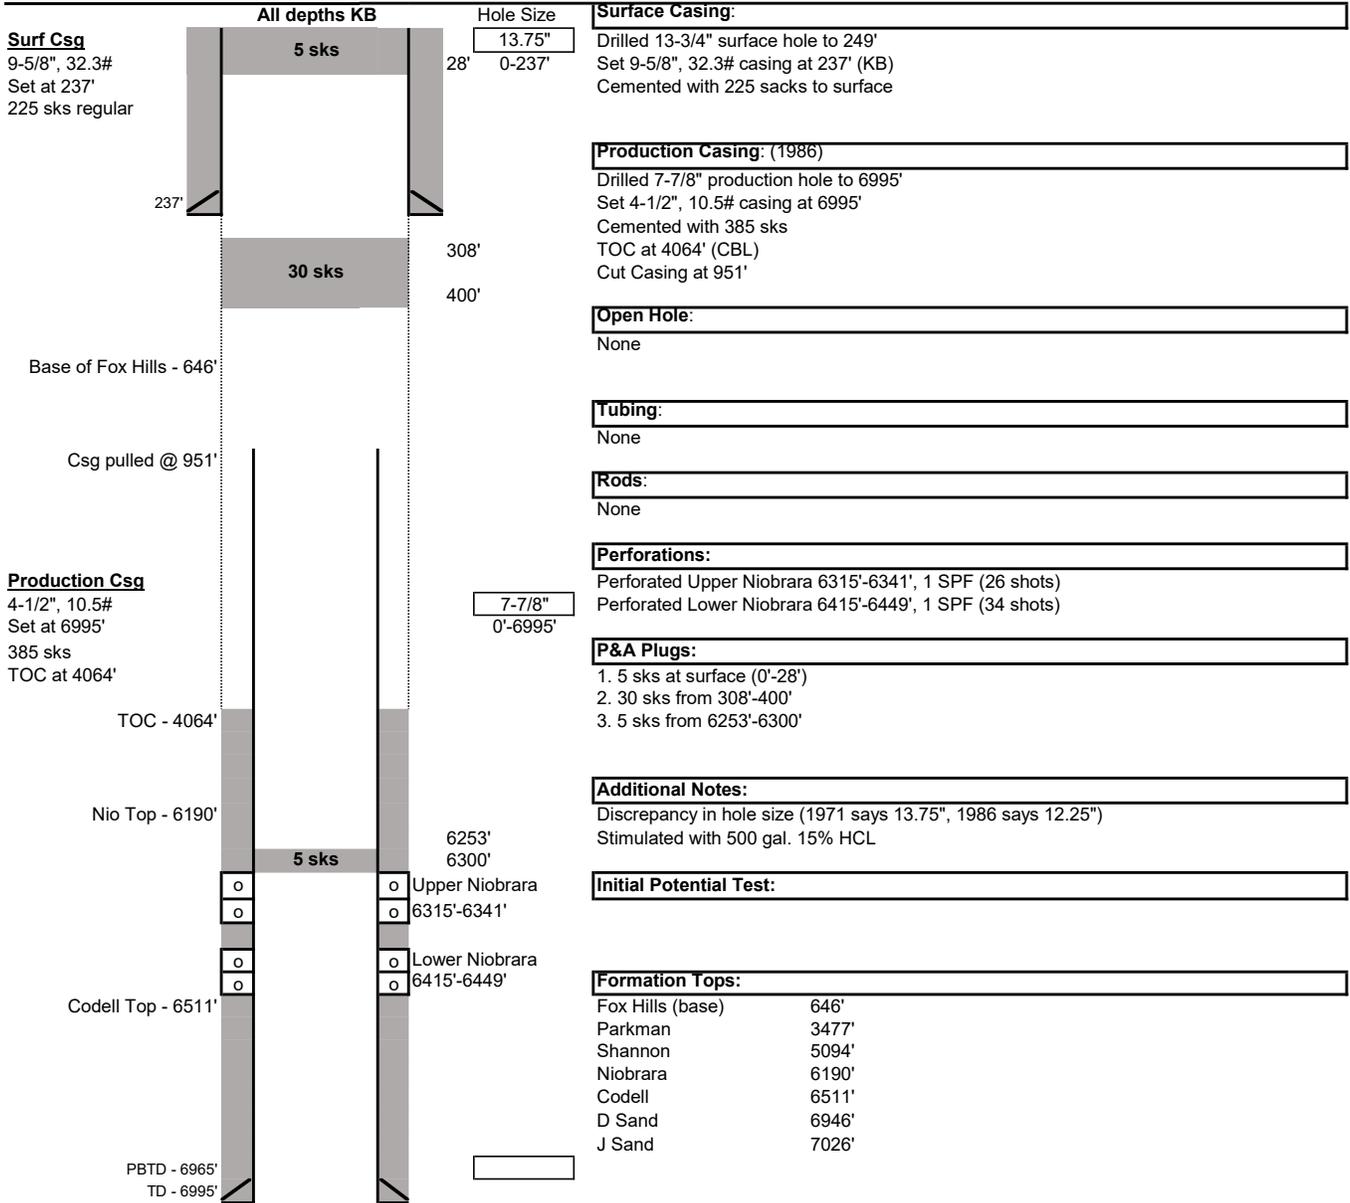

PBTD - 6965'  
TD - 6995'