

79-93



00047908


CERTIFICATE OF SURVEY  
for  
Patrick A. Doheny  
Washington County, Colorado

RECEIVED

FEB 14 1979

COLO. OIL & GAS CONS. COMM.

T2N R53W 6PM

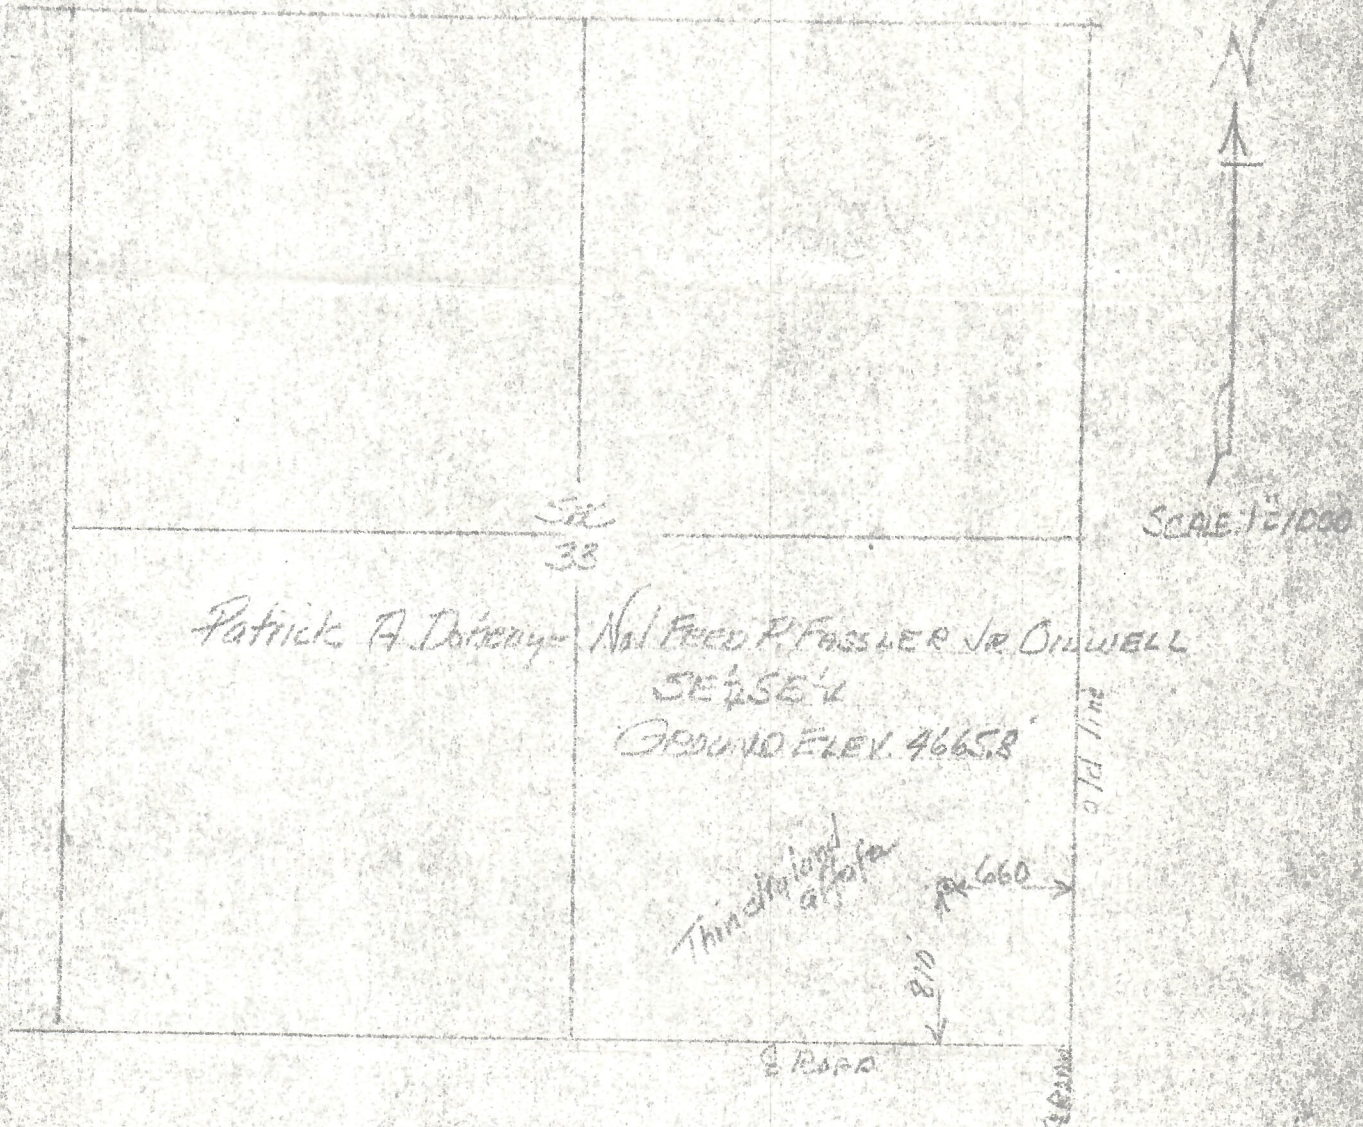

I hereby certify that the above plat is an accurate representation of a correct survey showing the location of Patrick A. Doheny-No.1 Fred P. Fassler Jr. Oilwell in SE 1/4 SE 1/4 Sec. 33 T2N R53W 6PM. The elevation of the ground at the stake is 4665.8 feet above sea level from U.S.G.S. Bench Mark.

Port Morgan, Colorado  
Feb. 7, 1979

*Cecil J. Osborne*  
Registered Professional Engineer  
State of Colorado

BEST IMAGE  
AVAILABLE