


CERTIFICATE OF SURVEY
for
Snyder Drilling Co.
Weld County, Colorado

RECEIVED

JUN 28 1973

T11N R62W 6PM

COLD OIL & GAS (unconformity)

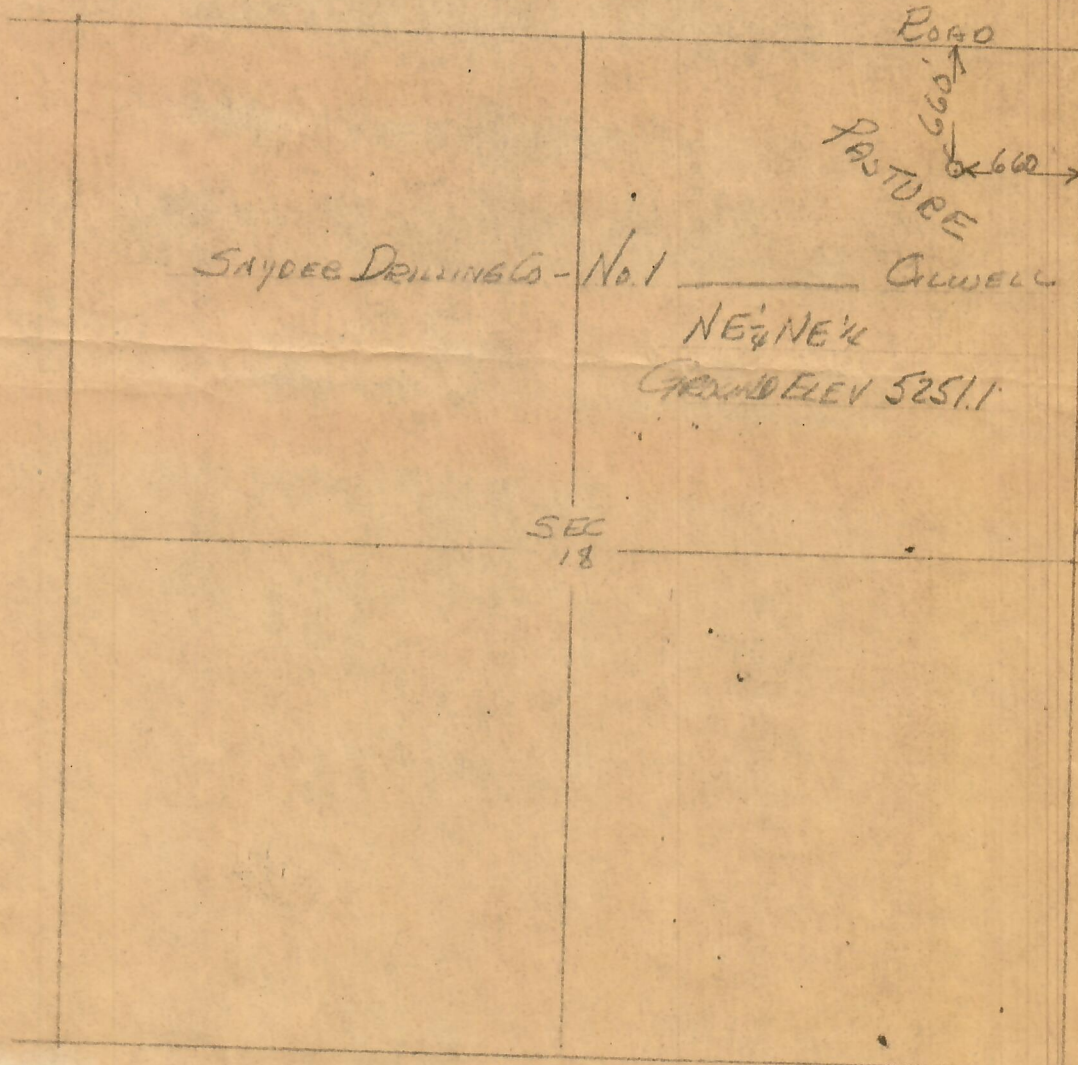

I hereby certify that the above plat is an accurate representation of a correct survey showing the location of Snyder Drilling Co.-No.1 Solomon Oilwell in NE 1/4 NE 1/4 Sec. 18 T11N R62W 6PM. The elevation of the ground at the stake is 5251.1 feet above sea level from U.S.C.&G. Bench Mark.

Fort Morgan, Colorado
June 17, 1973

Richard J. Carlson
Registered Professional Engineer
State of Colorado



00290015

Permit # 73-354