


CERTIFICATE OF SURVEY
for
Snyder Drilling Co.
Welds County, Colorado

RECEIVED

OCT 17 1973

COLORADO OIL & GAS COM. COMM.

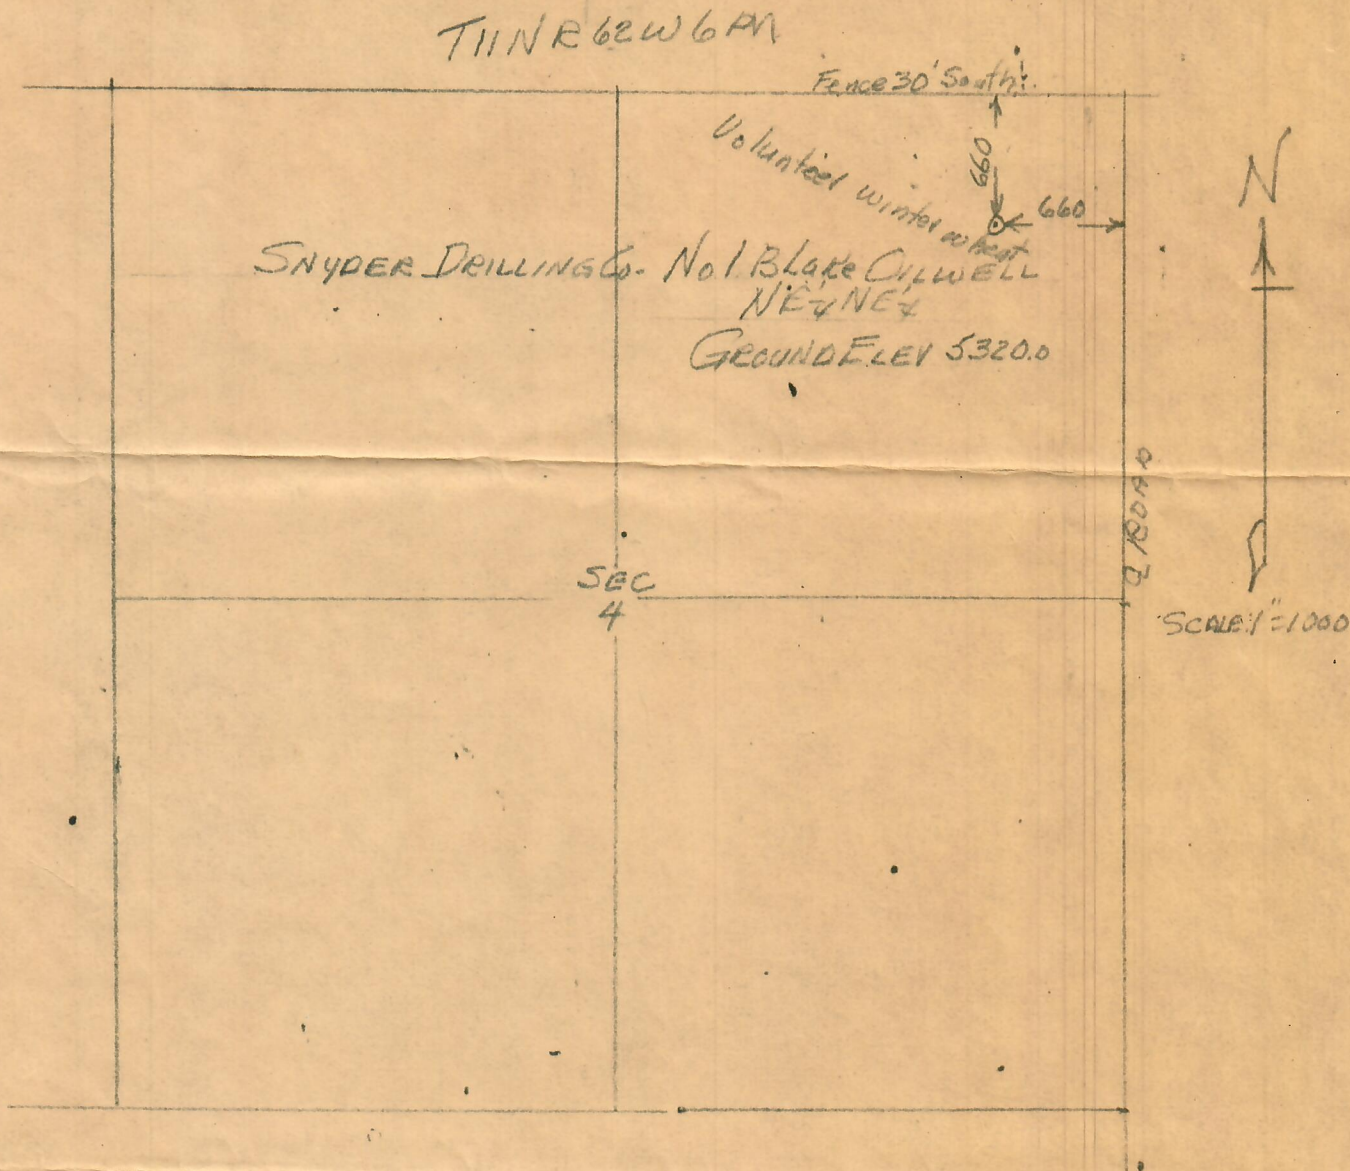

I hereby certify that the above plat is an accurate representation of a correct survey showing the location of Snyder Drilling Co., No. 1 Blake Oilwell in NE 1/4 NE 4 Sec. 4 T11N R62W 6PM. The elevation of the ground at the stake is 5320.0 feet above sea level from U.S.C. & G. Bench Mark.

Fort Morgan, Colorado
Oct. 11, 1973

Cecil Osborne
Registered Professional Engineer
State of Colorado

73-827



00290001