


## Attachment #1 – Current Wellbore Diagram

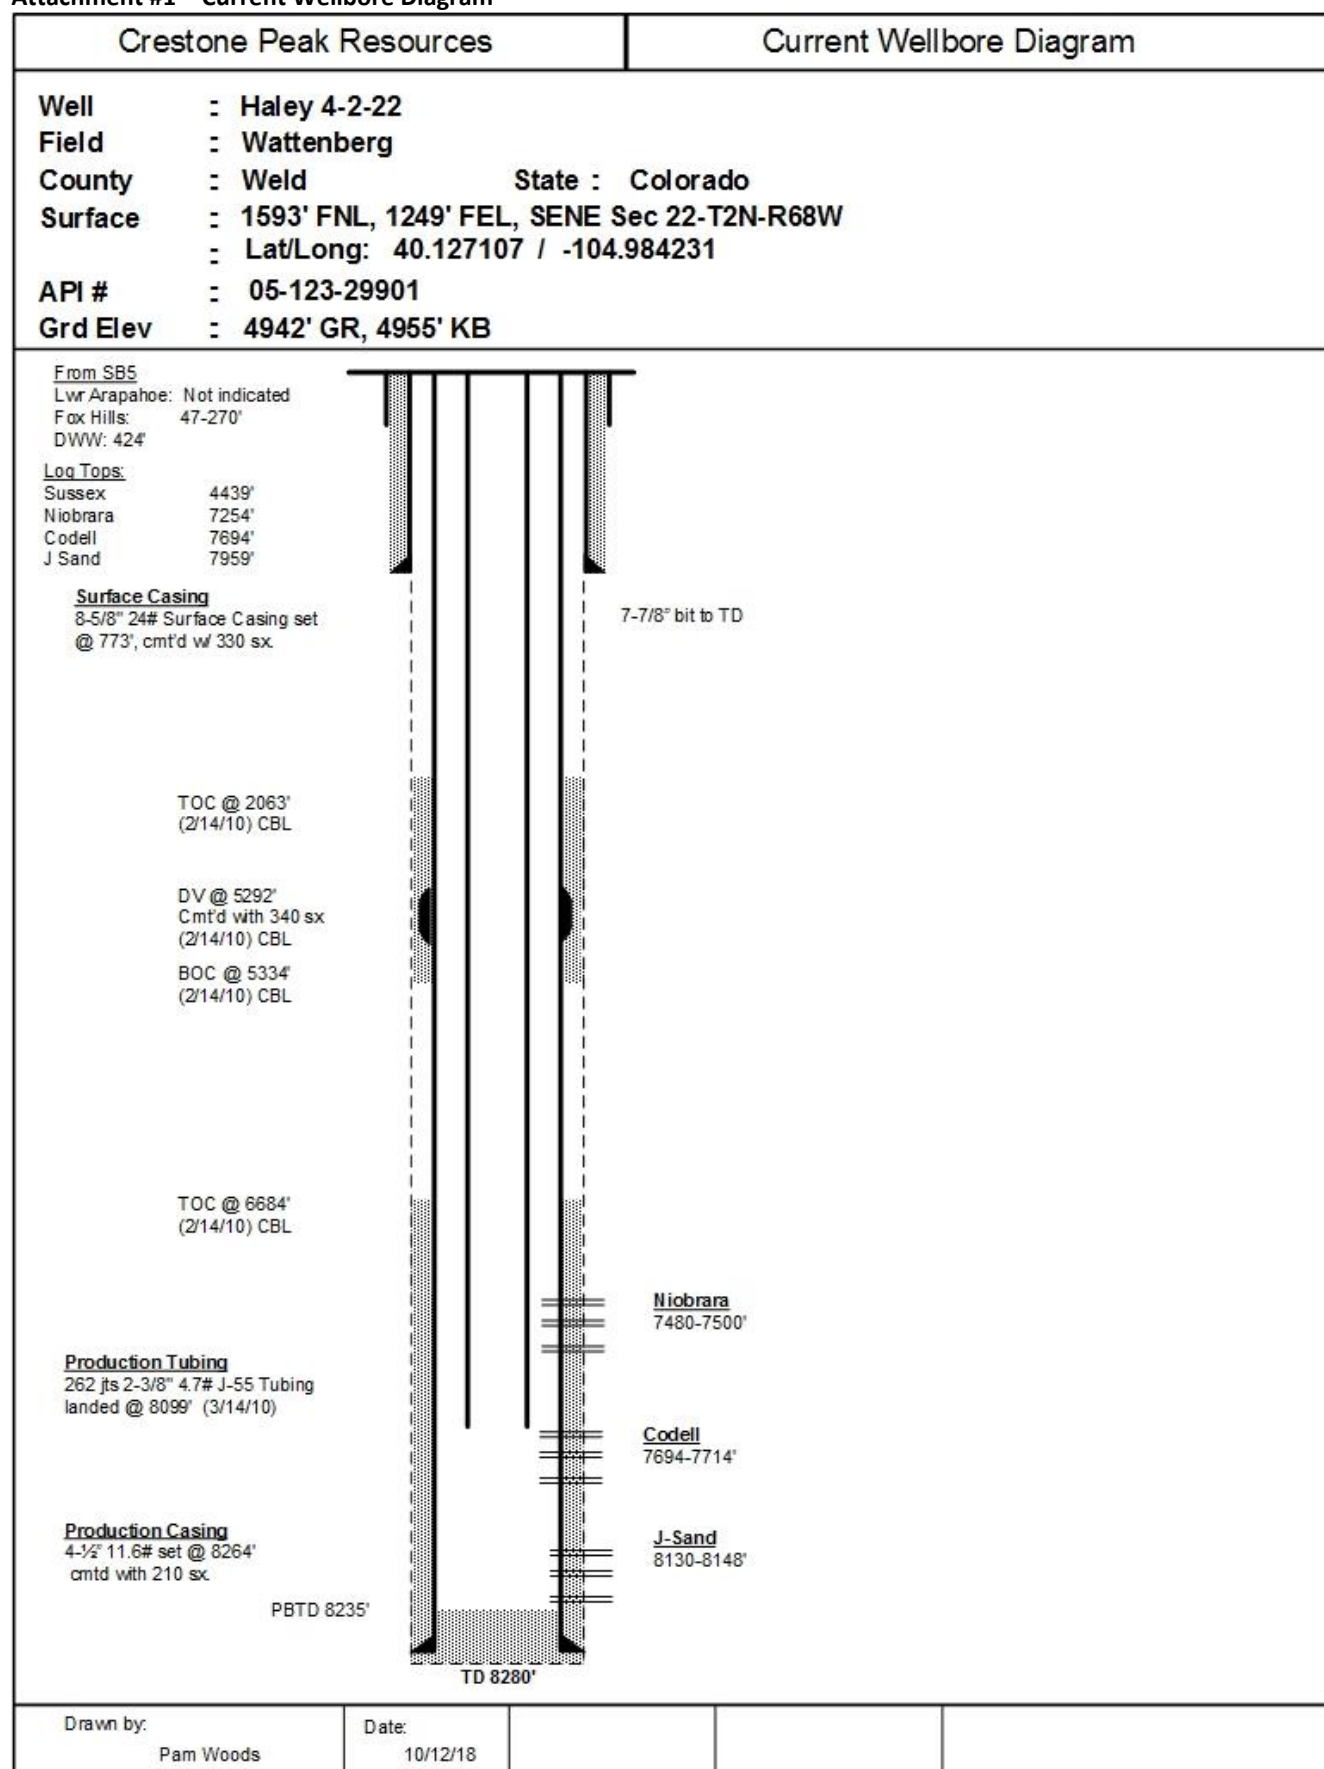

Attachment #2 – Proposed Plugged Wellbore Diagram

