



FORM F-106

RECEIVED


NOV 18 1971



01095538

R. 59W

COLORADO OIL & GAS COMS. COMM.

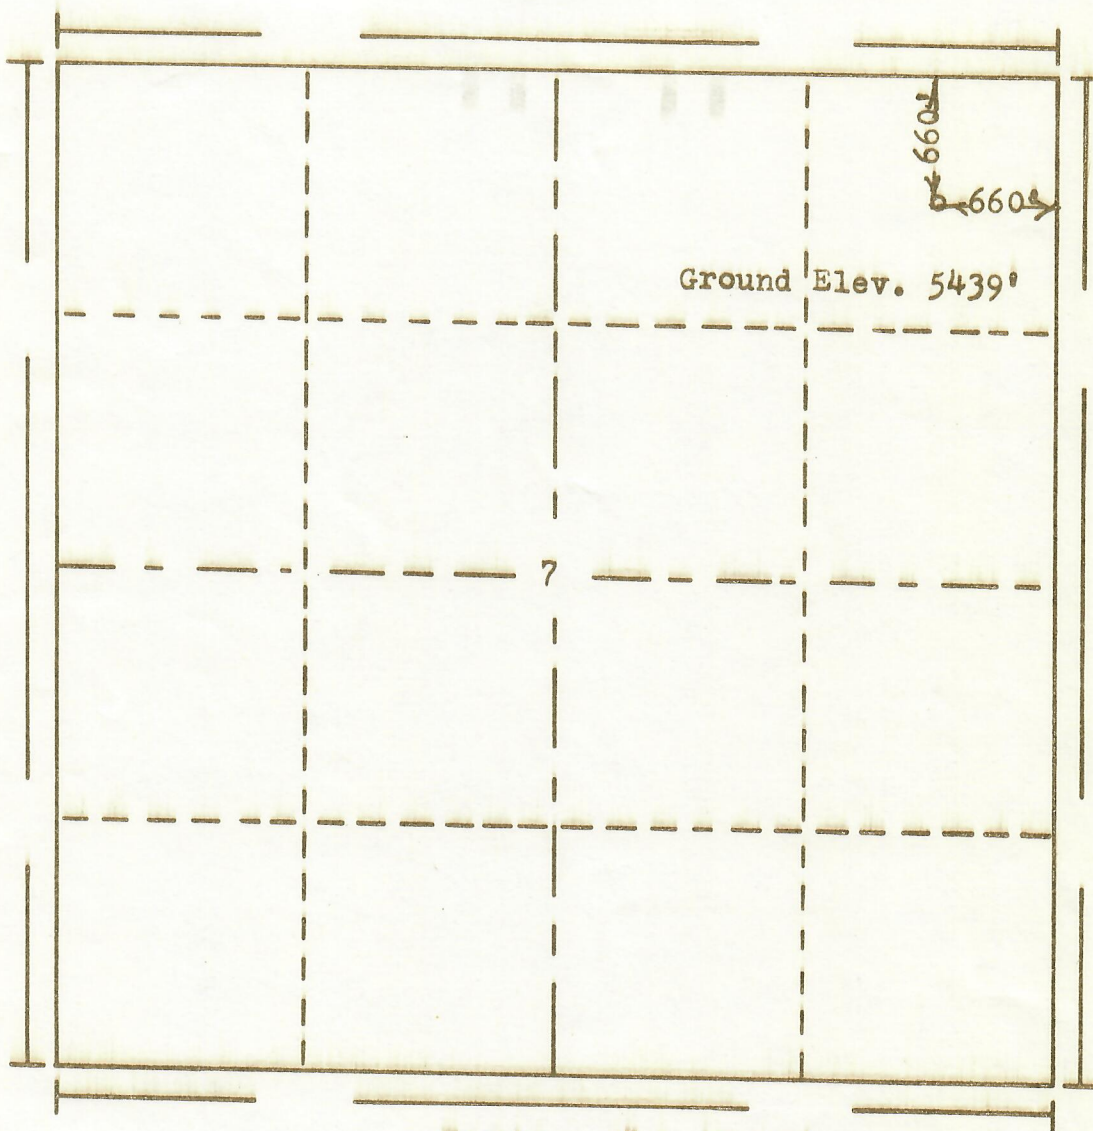

Scale... 1" = 1000'

Powers Elevation Company, Inc. of Denver, Colorado
has in accordance with a request from Mr. Groom
for Davis Oil Co.

determined the location of No. 1 Harms
to be CNE NE

Section 11 Township 11N
Range 59W of the 6th Principal Meridian
Weld County, Colorado

I hereby certify that this plat is an
accurate representation of a correct
survey showing the location of

Date: 9-30-71

B. G. Groom
Licensed Land Surveyor No. 2853
State of Colorado