


FOSS 10-2-21 AS-BUILT FLOWLINE EXHIBIT

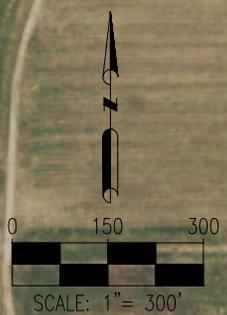

LEGEND:	= WELL HEAD = RISER = FLOWLINE	FOSS 10-2-21 FOSS 10-2-21 RISER AT WELLHEAD FOSS 10-2-21 RISER AT SEPARATOR	
----------------	--------------------------------------	---	--

 7535 Hilltop Circle Denver, CO 80221 (303) 928-7128 www.ascentgeomatics.com	FIELD DATE: 08-21-18	SURFACE LOCATION: SEC. 10, T6N, R64W, 6TH P.M. WELD COUNTY, COLORADO	PREPARED FOR:
	DRAWING DATE: 09-10-18		
	BY: JW	CHECKED: SJH	