

T5S, R96W, 6th P.M.

1917 Brass Cap
2.3' High
Lat: 39.636808°
Long: 108.164797°

1917 Brass Cap
1.3' High
Lat: 39.636814°
Long: 108.155431°

1917 Brass Cap
1.3' High
Lat: 39.636825°
Long: 108.146133°

S89°59'42"W - 2638.90' (Meas.)

S89°55'33"W - 2619.23' (Meas.)

S00°02'33"E - 2632.90' (Meas.)

N00°09'45"W - 2633.18' (Meas.)

1917 Brass Cap
2.5' High, Mound
of Stones
Lat: 39.629583°
Long: 108.164786°

1917 Brass Cap
2.0' High
Lat: 39.629600°
Long: 108.146103°

10

(AS-DRILLED)
NPR 14C-10 596

Elev. Graded Ground = 6709.4'

2479'
Wellbore

1469'

1243'

Bottom
Hole

Top Of Gas
Interval

1917 Brass Cap
2.0' High, Pine Post
Lat: 39.622331°
Long: 108.164769°

W.C.
1917 Brass Cap
Lat: 39.622331°
Long: 108.157622°

True Position
Lat: 39.622328°
Long: 108.155408°

True Position
Lat: 39.622333°
Long: 108.146122°

S89°59'59"W - 2616.84' (True to True)

-N89°57'05"W - 2637.38' -
(Meas. to True)

PDOP = 3.7

Caerus Oil & Gas LLC

(AS-DRILLED) NPR 14C-10 596
NE 1/4 SW 1/4, SECTION 10, T5S, R96W, 6th P.M.
GARFIELD COUNTY, COLORADO

BASIS OF BEARINGS

BEARINGS ARE A BASED ASSUMPTION THAT THE EAST LINE OF
THE NORTHEAST 1/4 OF SECTION 10 BEARS N00°09'45"W.
MONUMENTS DESCRIBED HERON.

BASIS OF ELEVATION

SPOT ELEVATION AT THE NORTHWEST CORNER OF SECTION 30, T5S, R95W, 6th P.M., TAKEN
FROM THE FORKED GULCH QUADRANGLE, GARFIELD COUNTY, COLORADO, 7.5 MINUTE
QUAD. (TOPOGRAPHIC MAP) PUBLISHED BY THE UNITED STATES DEPARTMENT OF THE
INTERIOR, GEOLOGICAL SURVEY. SAID ELEVATION IS MARKED AS BEING 5966 FEET.

LEGEND:

- = 90° SYMBOL
- = AS-DRILLED WELLHEAD.
- ◆ = TOP OF GAS INTERVAL
- = BOTTOM HOLE.
- ▲ = SECTION CORNERS LOCATED. (NAD 83)
- △ = SECTION CORNERS RE-ESTABLISHED.
(Not Set on Ground.) (NAD 83)

NOTE:
WELLBORE DATA PROVIDED
BY Caerus Oil & Gas LLC.

LINE TABLE


LINE	DIRECTION	LENGTH
L1	S89°57'05"E	623.70'
L2	S89°54'44"E	1114.74'



CERTIFICATE

THIS IS TO CERTIFY THAT THE ABOVE PLAT WAS PREPARED AND
LOCATION AS SHOWN WAS STAKED ON THE GROUND FROM FIELD NOTES
OF ACTUAL SURVEYS MADE BY ME OR UNDER MY SUPERVISION AND THAT
THE SAME ARE TRUE AND CORRECT TO THE BEST OF MY KNOWLEDGE AND
BELIEF.

REGISTERED LAND SURVEYOR
REGISTRATION NO. 180
STATE OF COLORADO

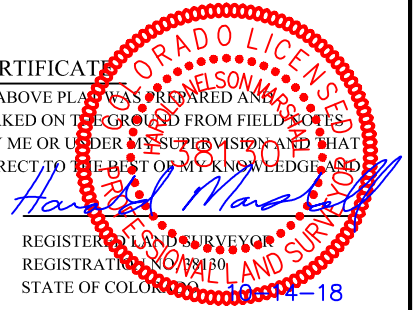

N89°54'44"W

2630.73' (Meas. to True)

W.C. SE Cor. Sec. 10
1917 Brass Cap, 2.0' High
Lat: 39.622328°
Long: 108.142167°

S 1/4 Cor. Sec. 11
1917 Brass Cap,
2.3' High
Lat: 39.622325°
Long: 108.136786°

NAD 83 (AS-DRILLED LOCATION)	NAD 83 (TOP OF GAS INTERVAL)	NAD 83 (BOTTOM HOLE)
LATITUDE = 39°37'39.10" (39.627528)	LATITUDE = 39°37'34.77" (39.626324)	LATITUDE = 39°37'33.89" (39.626080)
LONGITUDE = 108°09'21.53" (108.155981)	LONGITUDE = 108°09'34.43" (108.159563)	LONGITUDE = 108°09'37.31" (108.160364)
NAD 27 (AS-DRILLED LOCATION)	NAD 27 (TOP OF GAS INTERVAL)	NAD 27 (BOTTOM HOLE)
LATITUDE = 39°37'39.19" (39.627552)	LATITUDE = 39°37'34.85" (39.626348)	LATITUDE = 39°37'33.97" (39.626104)
LONGITUDE = 108°09'19.24" (108.155345)	LONGITUDE = 108°09'32.14" (108.158927)	LONGITUDE = 108°09'35.02" (108.159728)
UTM NAD 27 (ZONE 12)	UTM NAD 27 (ZONE 12)	UTM NAD 27 (ZONE 12)
N: 14403116.44 E: 2441459.19	N: 14402645.94 E: 2440464.20	N: 14402549.86 E: 2440241.40



UELS, LLC
Corporate Office * 85 South 200 East
Vernal, UT 84078 * (435) 789-1017

SURVEYED BY	DAYTON SLAUGH	10-12-18	SCALE
DRAWN BY	M.D.	10-12-18	1" = 1000'
AS-DRILLED WELL LOCATION PLAT			